



CONSTRUCTION REDLINE EDITS FOR AS-BUILT PLANS

Contents

CONTENTS	1
OVERVIEW	2
Process Provenance	2
STATEMENT OF NEED	2
ACRONYMS/DEFINITIONS USED IN THIS DOCUMENT	2
REFERENCES	2
PROCESS DESCRIPTION AND EXAMPLES	3
Section I. Redline As-Built Changes to the Plan Sheets	3
Procedure – As-Built Title Page Information	3
Procedure – As-Built Table of Contents Information	4
Procedure – As-Built Notes Information	5
Procedure – As-Built Linear and Level Data Information	6
Procedure – As-Built Control Diagram Information	7
Procedure – As-Built Typical Section Information	8
Procedure – As-Built Road Summaries Information	9
Procedure – As-Built Detail Sheet Information	13
Procedure – As-Built Plan and Profile Information	16
Procedure – As-Built Signing Plans Information	21
Procedure – As-Built Electrical Plans Information	26
Procedure – As-Built Bridge Plan Information	29
Procedure – As-Built Cross Section Information	31

Overview

This document will help guide construction crews through completing accurate redline as-builts in the field prior to submitting the as-builts to the designated person building electronic versions of the as-builts. This document should be taken as a guide and not an all-inclusive set of instructions. There are many aspects to as-built information and unique situations that may not be captured in this document. If further guidance is necessary, please contact your designated as-built specialist, typically the District Engineering Contract Specialist/District Engineering Officer.

Process Provenance

- Date of development: *7/19/2021*
- Revision date(s): *2/14/2022*
- Software: *N/A*
- Software version(s): *N/A*
- Author: *Emily Peterson & Christian Wright*

Statement of Need

Change is a normal and expected part of the construction process. Changes can be the result of necessary design modifications, differing site conditions, material availability, value engineering and impacts from third parties to name a few. Beyond executing the change in the field, the change needs to be documented to show what was constructed. Construction As-Builts are used to show the finished condition of the work as it was constructed and accepted. Thereafter the drawings are used as a reference, especially for tort claims, to plan for changes, fix repairs or expansion.

Acronyms/Definitions Used in This Document

EPM – Engineering Project Manager
DEO – District Engineering Officer (Engineering Contract Specialist)
NSOP – Not Shown On Plans
QA – QA Suite (Quality Assurance Software Used by MDT)
Jasper – Jasper Reports (Report Software Used by MDT)
MicroStation – Software Used by MDT to Design Projects

References


[Electronic Edits for As-Built Plans](#)

Process Description and Examples

Section I. Redline As-Built Changes to the Plan Sheets

Procedure – As-Built Title Page Information

1. "AS-BUILT" text is to be in the center of the page below the project description. **Note:** This is only on the title page. Depending on the plan sheet type, this text will be located elsewhere. See each specific plan page type throughout this document for details. This is not especially important when redlining plans but must be completed when MicroStation drawings are completed. However, it is useful as a tool to track which sheets you have completed while redlining.
2. This text is added automatically while plotting the plans after completion.
3. If any changes were made to the project limits, those changes need to be documented here.
4. Letting Date: This date can be found in the Special Provisions on the 1st page of the Q&A.
Completion Date: Date the EPM signs the Final Acceptance CSB_17_2 form.
Project Manager: The EPM on this project.
5. Update any change to the plan length. This will also be noted on the mileage comparison in the crew's share drive.

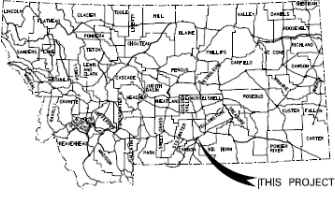

THIS PROJECT

AS-BUILT DATE SENSITIVE - FOR INFORMATION ONLY

MONTANA DEPARTMENT OF TRANSPORTATION

FEDERAL AID PROJECT NO. IM 90-8(174)432

BRIDGES, GRADE, GRAVEL, AND PLANT MIX SURFACE

WEST LAUREL INTCH - WEST (PHASE 2)

YELLOWSTONE COUNTY

AS-BUILTS

← LENGTH 0.4 MILES

2002 ADJ. = 12.00
2007 ADJ. = 14.50
2007 ADJ. = 25.00
EVAP. = 5.00
T. = 15.0%
V. = 10 MPH
18 IN. EGALS = 1.00
GROWTH RATE = 5.0%

EAG STAMPS			
2002 ADJ. = 210	N/A	N/A	N/A
2007 ADJ. = 300	3.000	2.000	4.000
2007 ADJ. = 640	5.500	5.000	8.000
EVAP. = 60	7.000	6.000	9.000
T. = 20.0%	3.0%	3.0%	20.0%
V. = 40 MPH	1.0%	1.0%	1.0%
18 IN. EGALS = 1.00	1.0%	1.0%	1.0%
GROWTH RATE = 5.0%	5.0%	5.0%	5.0%

MILEAGE STATEMENTS	
2002 ADJ. = 4.000	2007 ADJ. = N/A
2007 ADJ. = 4.000	2007 ADJ. = 5.000
2007 ADJ. = 5.000	2007 ADJ. = 10.000
EVAP. = 1.00	EVAP. = 1.00
T. = 5.0%	T. = 5.0%
V. = 40 MPH	V. = 40 MPH
18 IN. EGALS = 0.7	18 IN. EGALS = 1.0
GROWTH RATE = 5.0%	GROWTH RATE = 5.0%

LETTING DATE: FEBRUARY 21ST, 2014
 COMPLETION DATE: FEBRUARY 17TH, 2015
 PROJECT MANAGER: JAMES STEVENSON

CSF # 0.99951087

THIS CONTRACT END PROJECT IM 90-8(174)432
 STA. 237+04.47
 R.F. 0.0 TO R.F. 0.5

STA. 241+07.80
 NEW 56.00' x 241.88' BRIDGE

STA. 213+17.74
 REG. PROJECT IM 90-8(174)432

PLANS PREPARED BY: MORRISON-MAIERLE, INC.
 ENGINEERING: JACOB K. BOYD
 DESIGN: JAMES STEVENSON
 PHONE: 406.444.0000
 FAX: 406.444.0000

ASSOCIATED PROJECT AGREEMENT NUMBERS
 P. I. E.

MDTA MONTANA DEPARTMENT OF TRANSPORTATION
 MORRISON MAIERLE
 ROAD PLANS
 YELLOWSTONE COUNTY

MORRISON-MAIERLE, INC.
 BY: MATTHEW JAMES POOL
 DATE: _____
 MONTANA PROFESSIONAL ENGINEER
 LICENSE NO. 15445 PE

RECEIVED: _____ DATE: _____
 CONSULTANT DESIGN ENGINEER
 U.S. DEPARTMENT OF TRANSPORTATION
 FEDERAL HIGHWAY ADMINISTRATION

APPROVED: _____ DATE: _____
 DIVISION ADMINISTRATOR

Procedure – As-Built Table of Contents Information

1. Add additional summaries that were not originally included in the plans to the “SUMMARIES” section under the TABLE OF CONTENTS. In most cases you will have a Miscellaneous Bid Items Summary and a Contract Adjustments Summary.
2. Add any additional details, plan sheets, or other items that were not included in the original plans in their respective sections.

AS-BUILTS DATE SENSITIVE - FOR INFORMATION ONLY

TABLE OF CONTENTS

ROAD PLANS	SHEET NO.	ROAD PLANS CONT.	SHEET NO.
TITLE SHEET	1	PLAN & PROFILE	26-32
TABLE OF CONTENTS	2	RAMP K1	26
NOTES	3	RAMP K2	27
LINEAR & LEVEL DATA	4	RAMP K3	28
CENTERLINE COORDINATE TABLE	4	RAMP K4	29
CONTROL DIAGRAM	5	19TH AVE. WEST	30
TYPICAL SECTIONS	6-14	GOLF COURSE RD. / PUBLIC APPROACH	31
SUMMARIES	15-18	MAIN ST.	32
GRADING	15	SIGNING PLANS	
ADDITIONAL GRADING	15	SUMMARY	S1
PAVEMENT MARKINGS	15	LOCATION & SPECIFICATION DETAILS	S2-S5
RETAINING WALLS	15	DETAILS	S6-S7
TOPSOIL & SEEDING	15	PLANS	S8-S14
CONCRETE SLOPE PROTECTION	15	ELECTRICAL PLANS	
BRIDGE END BACKFILL	15	SUMMARY	E1
FENCING	15	DETAILS	E1-E4
RUMBLE STRIPS	15	PLANS	E5-E6
SURFACING	16	BRIDGE PLANS	
ADDITIONAL SURFACING	16	BRIDGE PLANS	B1-B10
GUARDRAIL	17	STANDARD DRAWINGS	2 SHEETS
ENHANCEMENT PROTECTION	17	CROSS SECTIONS	
MEDIAN CROSSOVER	17	RAMP K1	1-10
STABILIZATION (GEOTEXTILE FABRIC)	17	RAMP K2	11-24
PROTECTION & DRAINAGE STRUCTURES	17	RAMP K3	25-34
OIL SPILLAGE ROADWAY	17	RAMP K4	35-42
RAILROADS	17	19TH AVE. W.	43-58
FENCE TREES	17	GOLF COURSE RD.	59-63
SMALLLANDSCAPE ITEMS	17	MAIN STREET	64-76
CONTRACT ADJUSTMENTS	17	PUBLIC APPROACH	77-79
CULVERTS	18		
APPROACH PIPE	18		
COLD MILLING	18		
DETAILS	19-25		
PHASE 2 HYDRAULIC SITE MAP	19		
19TH AVE SPURWAY STA. 226+52 DETAIL	20		
INTERSECTION DETAILS	21-23		
19TH AVE BRIDGE ABUTMENT RETAINING WALL DETAILS	24		
BRIDGE END GRADING & BRIDGE END SHOULDER DETAIL	25		
FARM FENCE PANELS - SPECIAL DESIGN	25A		

ROAD PLANS AS-BUILTS WEST LAUREL BUTCH - WEST (PHASE 2) PROJECT NO./M. 20-017648Z

YELLOWSTONE COUNTY CDF # 039959087 UPN NUMBER 6736003 SHEET 2 OF 32

3. Place “AS-BUILTS” in the lower title box next to the plans type. **Note:** This will be the same location for all plan sheets except for the title sheet and bridge plan sheets. On older plans (examples later in document), this text box may not be present. These are mostly phased out, but if you come across a set while completing as-builts, place this text in the upper, right corner.

Procedure – As-Built Notes Information

1. Mark up any changes to original plans.

AS-BUILTS DATE SENSITIVE - FOR INFORMATION ONLY Highways & Engineering Division

NOTES

BASIS OF PLAN QUANTITIES
(QUANTITIES FOR ESTIMATING PURPOSES ONLY)

COMP. AGGREGATE WEIGHT = 3750 LBS. PER CUBIC YARD
 COMP. RESCUE OF FL. AND BIT. SURF. = 4462 LBS. PER CUBIC YARD
 ASPHALT CEMENT - GRADE 5 - 3/4" AGG. = 5.43 OF FL. W/ BIT. SURF. (PROJECT SPECIFIC)
 UNDESIGNED LINE = 1.46 OF FL. W/ BIT. SURF.
 UNDESIGNED MATERIAL = 8.5 LBS. PER GAL.
 UNDESIGNED ASPHALT - TACK (HOT SURFACES) = 0.45 GAL. PER SQ. YARD (UNDESIGNED)
 UNDESIGNED ASPHALT - TACK (CONCRETE SURFACES) = 0.15 GAL. PER SQ. YARD (UNDESIGNED)
 UNDESIGNED ASPHALT - FOG SEAL (5 & 1) = 0.075 GAL. PER SQ. YARD (UNDESIGNED)
 UNDESIGNED ASPHALT - FOG SEAL (HARDER STRIPS) = 0.15 GAL. PER SQ. YARD (UNDESIGNED)
 SEAL = 0.42 GAL. PER SQ. YARD
 OTHER = 25 LBS. PER SQ. YARD

CLEARING AND GRUBBING
 CLEAR AND GRUB TO CONSTRUCTION LIMITS. INCLUDE THE COST OF CLEARING AND GRUBBING IN THE UNIT PRICE #8 FOR UNCLASSIFIED EXCAVATOR.

COMBINATION SCALE FACTOR
 ALL COORDINATES ARE STATE PLANE (SEE CONTROL DIAGONAL).
 CSF OF PROJECT IS 0.9995807.

PUBLIC LANDS SURVEY MONUMENT
 ALL MONUMENTS TO BE REMOVED AND RELOCATED OR RESET BY STATE FORCES.

SOILS INFORMATION
 SEE SPECIAL PROVISIONS FOR ADDITIONAL INFORMATION. THE LOCATION FOR GEOTECHNICAL BORINGS IS SHOWN ON THE PLAN VIEW WITH THE FOLLOWING SYMBOL:
 (GEOTECHNICAL BORING)

UTILITIES
 CALL THE UTILITIES UNDERGROUND LOCATION CENTER (ULC) ON OTHER NOTIFICATION SYSTEM FOR THE MARKING AND LOCATION OF ALL LINES AND SERVICES BEFORE EXCAVATING. ALL CLEARANCES OR DEPTHS PROVIDED FOR UTILITIES ARE FROM EXISTING GROUND LINE.

APPROACHES
 CONTRACT APPROACHES TO A 24" FINISHED TOP ON A 34" SLOPES UNLESS NOTED OTHERWISE IN THE PLANS.
 PROVIDE THE FOLLOWING SURFACING:
 0.20" PLANT MIX BITUMINOUS SURF.
 0.50" CRUSHED AGGREGATE COURSE

PLANT MIX SURFACE ALL PRIVATE APPROACHES TO SINK.
QUANTITIES FOR ONE PRIVATE APPROACH:
 ASPHALT LAYERS = 30 Inches Thick
 PLANT MIX BITUMINOUS SURF. = 21 Tons
 CRUSHED AGGREGATE COURSE = 48 Tons
 ASPHALT CEMENT = 1.21 Tons

GRAVEL SURFACE ALL PAVEMENT APPROACHES TO SINK WITH A 12.0% SLOPE PLANT MIX SURF. ADJACENT AND PARALLEL TO THE ROADWAY.
QUANTITIES FOR ONE PAVEMENT APPROACH:
 ASPHALT LAYERS = 30 Inches Thick
 PLANT MIX BITUMINOUS SURF. = 7 Tons
 CRUSHED AGGREGATE COURSE = 31 Tons
 ASPHALT CEMENT = 0.4 Tons

WETLANDS
 WETLANDS EXIST ADJACENT TO THE ROADWAY AND BEYOND THE PROJECT LIMITS. WETLAND AREAS AND PERMITTED WETLAND IMPACT AREAS WITHIN THE PROJECT LIMITS HAVE BEEN DELINEATED AND ARE SHOWN ON THE PLANS. ANY ACTION IMPACTING WETLAND AREAS WITHIN THE APPROPRIATE PERMITTING IS THE RESPONSIBILITY OF THE CONTRACTOR.

WETLANDS LEGEND

- DELIMITED WETLAND AREAS
- PERMITTED WETLAND AREAS
- PERMITTED WETLAND IMPACT AREAS
- PERMITTED OPEN WATER AREAS

WETLAND DELINEATION

WETLAND DESIGNATION	STATION		DELIMITED AREA	IMPACTED AREA (TEMP.)	IMPACTED AREA (PERMAN.)
	FROM	TO			
W1-005	89+29	71+60	0.28		0.275
W1-006	12+40	18+72	0.28		0.275
W1-010	12+00	13+00	0.015		0.015
TOTALS			1.265		0.565

SKREW DIAGRAM

WEST LAUREL INTERCHANGE PHASE 2 SITE PLAN

MDTA MONTANA DEPARTMENT OF TRANSPORTATION

DESIGNED BY: [Name]

CHECKED BY: [Name]

DATE: [Date]

ROAD PLANS

YELLOWSTONE COUNTY

AS-BUILTS

WEST LAUREL INTCH - WEST PHASE 2

CSF = 0.9995807

UPN NUMBER 5730603

PROJECT NO./IM 60-40176432

SHEET 3 OF 32

Note: Oftentimes this is included on another page such as the Table of Contents page (example below) but can be its own page, like above, depending on size.

AS-BUILTS DATE SENSITIVE - FOR INFORMATION ONLY Highways & Engineering Division

NOTES

TABLE OF CONTENTS

ROAD PLANS	SHEET NO.
TITLE SHEET	1
TABLE OF CONTENTS	2
NOTES	2
LINEAR DATA	2
TYPICAL SECTIONS	3
SUMMARIES	4-5
APPROACHES	4
UTILITIES	4
AS-BUILTS	4
STATIONING - REFERENCE POSTS	4
WETLANDS	4
SIGNING PLANS	5
SUMMARY	51
SPECIFICATIONS	52 - 53
DETAILS	54

BASIS OF PLAN QUANTITIES
(QUANTITIES FOR ESTIMATING PURPOSES ONLY)

COMP. AGGREGATE WEIGHT = 3750 LBS. PER CUBIC YARD
 COMP. RESCUE OF FL. AND BIT. SURF. = 4462 LBS. PER CUBIC YARD
 ASPHALT CEMENT - GRADE 5 - 3/4" AGG. = 5.43 OF FL. W/ BIT. SURF. (PROJECT SPECIFIC)
 UNDESIGNED LINE = 1.46 OF FL. W/ BIT. SURF.
 UNDESIGNED MATERIAL = 8.5 LBS. PER GAL.
 UNDESIGNED ASPHALT - TACK (HOT SURFACES) = 0.45 GAL. PER SQ. YARD (UNDESIGNED)
 UNDESIGNED ASPHALT - TACK (CONCRETE SURFACES) = 0.15 GAL. PER SQ. YARD (UNDESIGNED)
 UNDESIGNED ASPHALT - FOG SEAL (5 & 1) = 0.075 GAL. PER SQ. YARD (UNDESIGNED)
 UNDESIGNED ASPHALT - FOG SEAL (HARDER STRIPS) = 0.15 GAL. PER SQ. YARD (UNDESIGNED)
 SEAL = 0.42 GAL. PER SQ. YARD
 OTHER = 25 LBS. PER SQ. YARD

UTILITIES
 CALL THE UTILITIES UNDERGROUND LOCATION CENTER (ULC) ON OTHER NOTIFICATION SYSTEM FOR THE MARKING AND LOCATION OF ALL LINES AND SERVICES BEFORE EXCAVATING. ALL CLEARANCES OR DEPTHS PROVIDED FOR UTILITIES ARE FROM EXISTING GROUND LINE.

AS-BUILTS
 FOR MATERIALS ALIGNMENT AND STATIONING REFER TO THE FOLLOWING TABLES:

STATIONING - REFERENCE POSTS
 REFERENCE POSTS ARE FROM NORTH TO SOUTH. STATIONING BEGINS FROM NORTH TO SOUTH.

WETLANDS
 WETLANDS EXIST ADJACENT TO THE ROADWAY AND BEYOND THE PROJECT LIMITS. WETLAND AREAS AND PERMITTED WETLAND IMPACT AREAS WITHIN THE PROJECT LIMITS HAVE BEEN DELINEATED AND ARE SHOWN ON THE PLANS. ANY ACTION IMPACTING WETLAND AREAS WITHIN THE APPROPRIATE PERMITTING IS THE RESPONSIBILITY OF THE CONTRACTOR.

LINEAR DATA

LENGTH OF ROADWAY	2 - LANE RURAL	44,680.26 ft
TOTAL LENGTH OF STPS 463-N716	2 - LANE RURAL	44,680.26 ft

MDTA MONTANA DEPARTMENT OF TRANSPORTATION

DESIGNED BY: [Name]

CHECKED BY: [Name]

DATE: [Date]

ROAD PLANS

YELLOWSTONE COUNTY

AS-BUILTS

SW OF LOOSE GRASS SW


UPN 5954000

3776 463-N716

2


Procedure – As-Built Control Diagram Information

1. Mark any changes to the original plans such as obliterated control points.

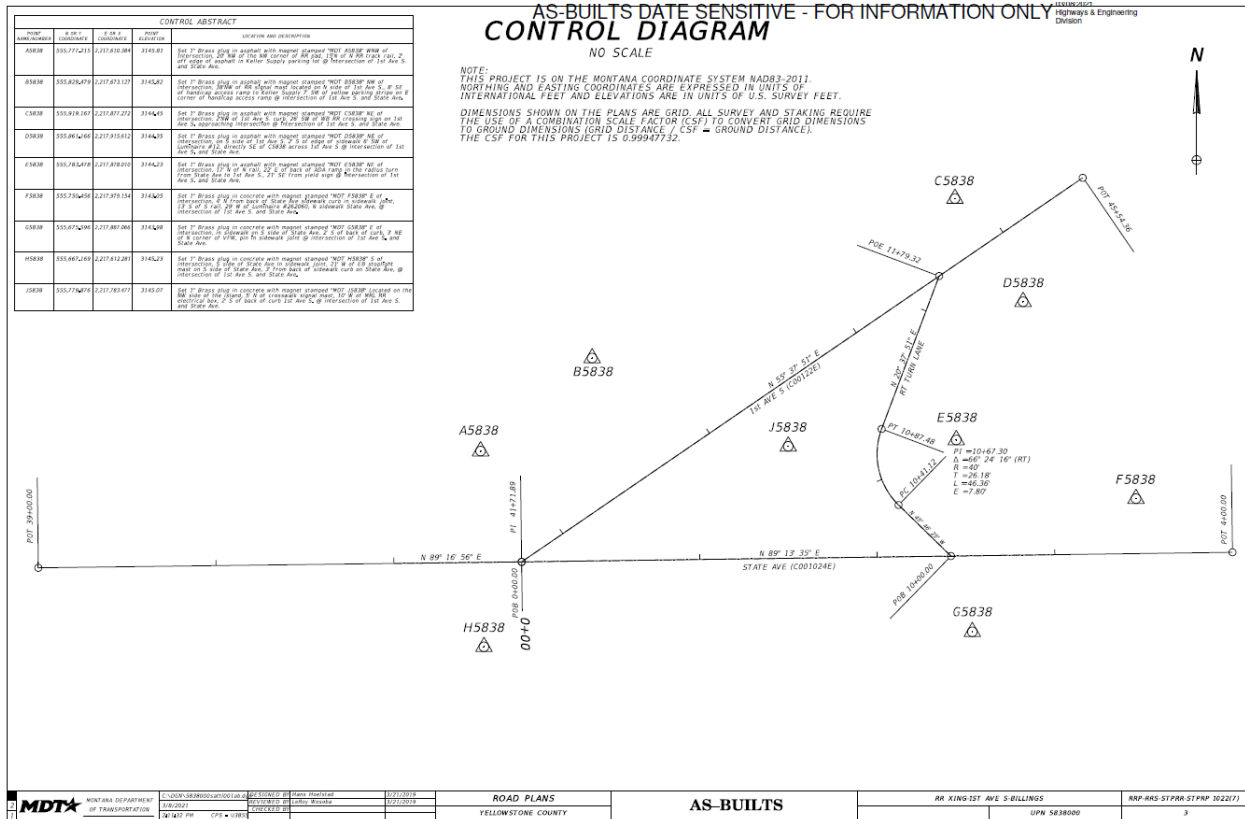

Procedure – As-Built Typical Section Information

1. Note any changes to typical sections. These can include:
 - a. Stations
 - b. Depths
 - c. Ditch Lines
 - d. Slopes
 - e. Widths

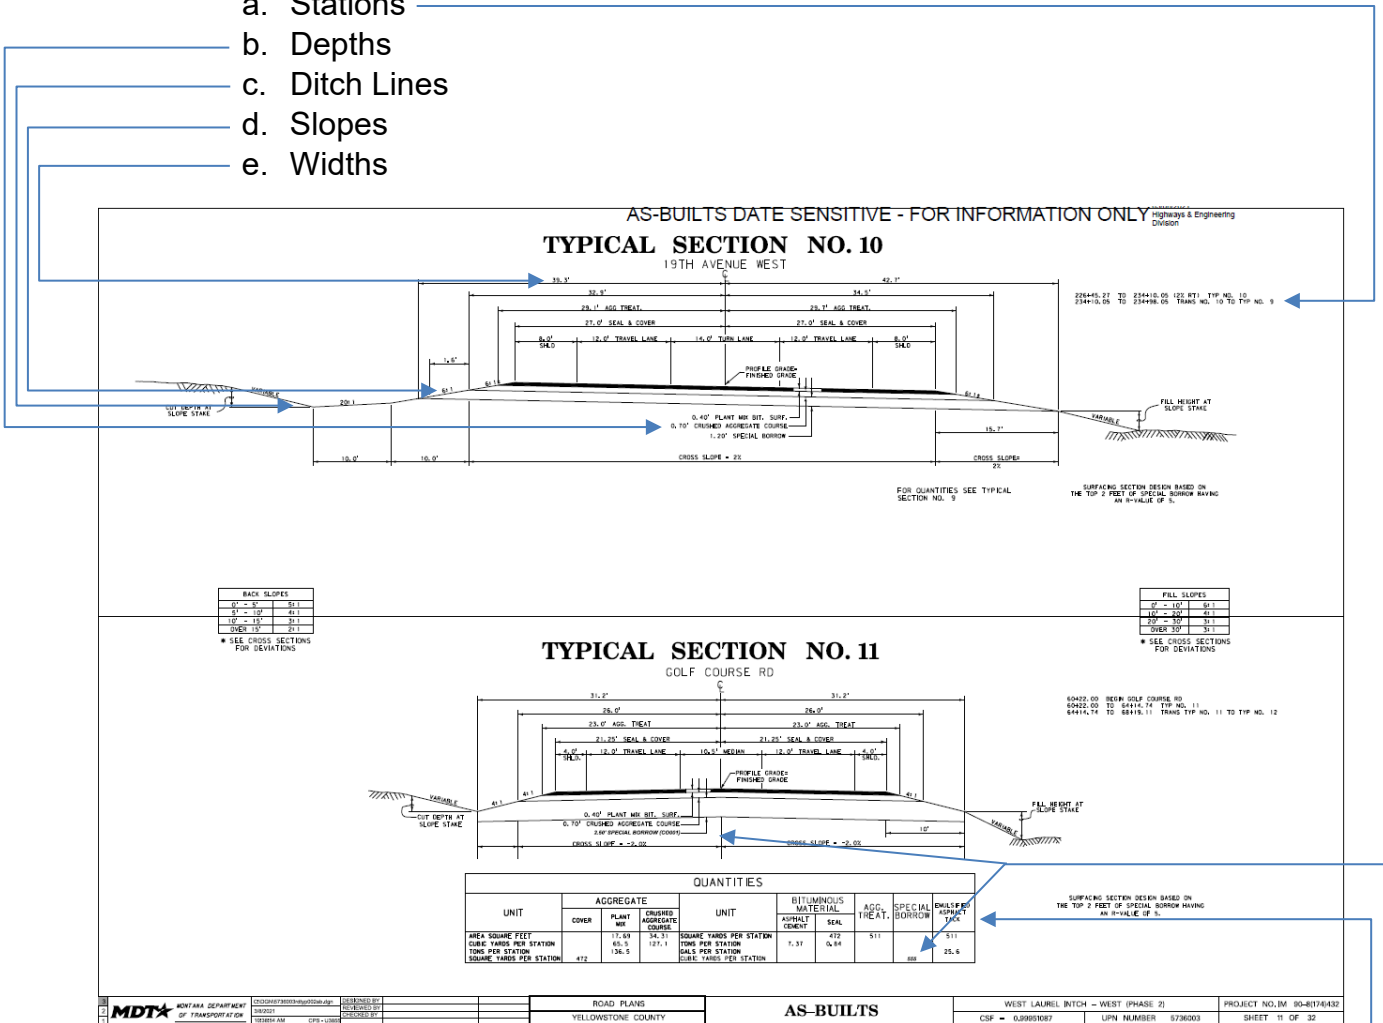

2. If any of the widths or depths change, the “QUANTITIES” summary under the typical section should be updated. If no changes were made to the typical sections, updating these to reflect actual placed quantities is not necessary as the information regarding project quantities will be included in the “SURFACING” summary later in the plans.
3. On this project, the special borrow was thickened in this typical section. The thickness was updated as well as the “QUANTITIES” table.

Procedure – As-Built Road Summaries Information

Note: Some plans have Excel summaries that are available on DMS. If you want to edit these instead of on the paper plans, the information will be the same, but the process will be slightly different. Instead of crossing out existing numbers and writing in new ones, information can just be deleted and replaced. Use **Arial font, bolded, and italicized** to show what has changed from plan. Editing MicroStation summaries is covered in [Electronic Edits for As Built Plans](#).

1. All bid items, including change ordered bid items, must be shown in the as-built's summaries. If any items are not included in existing summaries, these can be placed in a "MISCELLANEOUS BID ITEMS" summary.

MISCELLANEOUS BID ITEMS			
ITEM DESCRIPTION	QUANTITY	UNITS	REMARKS
CATEGORY NO 1			
TRAINING PROGRAM	359	HOUR	
ESCROW OF BID DOCUMENTS	1,000	LS	
MISCELLANEOUS WORK	28,319	UNITS	
CONTRACTOR SURVEY AND LAYOUT	1,000	LS	
CRITICAL PATH SCHEDULE	1,000	LS	
MOBILIZATION	1,000	LS	
TEMPORARY EROSION CONTROL - LS	1,000	LS	
TEMPORARY EROSION CONTROL	0	UNITS	ITEM NOT USED
TRAFFIC CONTROL DEVICES CB	230,514	UNITS	
TRAFFIC CONTROL CROSSOVER	2	EACH	
CATEGORY NO 4			
MISCELLANEOUS ITEMS - LS	1,000	LS	CO008
CATEGORY NO 5			
MGS GUARDRAIL	75	LNFT	CO008
REMOVE GUARDRAIL	75	LNFT	CO008
DELINATOR DES A	1	EACH	CO008

MISCELLANEOUS BID ITEMS			
ITEM DESCRIPTION	QUANTITY	UNITS	REMARKS
CATEGORY NO 1			
MISC WORK - CULVERT EXTENSION	2,200	UNITS	EXTENSION OF EXISTING NSDP 18" CULVERT AT 11+60 TO ACCOMMODATE NEW SLOPES
MISC WORK - MESSAGE BOARDS	2,640	UNITS	ADDITIONAL MESSAGE BOARDS
MISC WORK - SHOULDER TOPSOIL	5,025	UNITS	ADDITIONAL TOPSOIL REQUIRED BETWEEN EDGE OF PAVEMENT AND TOP OF SLOPE
MISC WORK - SOIL LIFT	5,568,000	UNITS	WETLAND RESTORATION UTILIZING SOIL LIFTS
MISC ITEMS - LS	0.000	LUMP SUM	SPECIAL PROVISION 23 - OFFICE TRAILER NOT USED
MOBILIZATION	1,000	LUMP SUM	
BMP ADMINISTRATION	1,000	LUMP SUM	
TEMPORARY EROSION CONTROL	0	UNITS	NOT USED
TRAFFIC CONTROL - FIXED	0	UNITS	NOT USED
TRAFFIC CONTROL - FIXED	1,000	LUMP SUM	

Note: Depending on what work was completed with Miscellaneous Work, quantities should be broken out.

2. All contract/item adjustments (QA incentive/deductions, fuel price, liquidated damages, etc.) also need to be included in a summary. This summary is called "CONTRACT ADJUSTMENTS" summary. For reference, these will all be listed in the Summary of Contract Adjustments Jasper report for the contract.

CONTRACT ADJUSTMENTS			
ADJUSTMENT TYPE	ADJUSTMENT AMOUNT	UNITS	LINE ITEM DESCRIPTION
NON QA ADJUSTMENT	\$ (1,499.00)	TON	HYDRATED LIME
QA CONCRETE	\$ 1,467.00	YD ³	CONCRETE - CLASS STRUCTURE
QA CONCRETE	\$ 3,190.00	YD ³	CONCRETE - CLASS STRUCTURE LOW SLUMP
QA CONCRETE	\$ 117.00	YD ³	FOUNDATION - CONCRETE
QA DENSITY	\$ 4,896.00	TON	PLANT MIX SURF GR S - 3/4 IN
QA RIDE SPEC	\$ (7,401.00)	TON	PLANT MIX SURF GR S - 3/4 IN
QA VOLUMETRICS	\$ 60,158.00	TON	PLANT MIX SURF GR S - 3/4 IN

3. The surfacing summary only requires that totals be entered at the bottom of the summary. If you have separate categories, list each category's total and an accumulated total at the bottom.

SURFACING																
STATION		linear feet				FOR	tons				cu yards				REMARKS	
		GROSS	NET	+	-		HYDRATED LIME	AGGREGATE	BITUMINOUS MATERIAL	cu yards						
FROM	TO						sq yards	tons	TRAFFIC GRAVEL	CRUSHED AGG. COURSE	ASPHALT CEMENT PG 70-28	SEAL CRS-2P	EMULSIFIED ASPHALT TACK	agg. TREAT		
213+17.74	225+57.27	1239.53	997.65		241.88	19TH AVE WEST										TYP NO. 9
225+57.27	225+45.27	88.00	88.00			19TH AVE WEST										TRANS. TYP NO. 9 TO TYP NO. 10
225+45.27	234+10.05	764.78	764.78			19TH AVE WEST										TYP NO. 10
234+10.05	234+98.05	88.00	88.00			19TH AVE WEST										TRANS. TYP NO. 10 TO TYP NO. 9
234+98.05	237+04.47	206.42	206.42			19TH AVE WEST										TYP NO. 9
ADDITIONAL SURFACING																
TOTAL		2,386.73	2,144.90		241.88		181.773	103,494.2	93,361.910	0	17,300.98	709.629	192.350	2.299	0	12,154.33

4. Summaries requiring more detail include guardrail, fencing, sidewalk, irrigation, drainage structure, and culverts. This is not an all-inclusive list. There may be other items that need just as much detail. A good indicator is if the item is underground. Having a good record of any underground items is important for as-builts. Items such as dig outs that include fabric and/or special borrow should also include location details so they can be marked up accurately on the plan and profile. Items like this give future designers an idea of where problem areas exist. Too much information is better than not enough when dealing with as-builts. When in doubt, include the extra information to ensure drawings are updated accurately in MicroStation.

FENCING													
STATION		linear feet				TEMP. FENCE	each				linear feet		REMARKS
		FARM FENCE		FARM FENCE PANEL - SPECIAL DESIGN			FARM GATE						
FROM	TO	TYPE F2M-48WW	TYPE F3M-48WW	TYPE F2M-39WW	TYPE F4M	SINGLE	DOUBLE	SINGLE	DOUBLE	TYPE G2	TYPE G3		
13+01LT	70+21LT					11	1				68	PANEL S GALVANIZED STEEL SET IN CONCRETE TIE TO CROSS FENCE (PARCEL 11)	
25+00RT	37+42.5RT			1,953	1,439			5	2			PANEL S GALVANIZED STEEL SET IN CONCRETE TIE TO CROSS FENCE (PARCEL 11)	
26+29.7LT	37+41.9LT	1,833										DOUBLE PANEL GALVANIZED STEEL SET IN CONCRETE (PARCEL 11)	
27+80RT								2			24	2x12 METAL FARM ENTRANCE GATES (PARCEL 11)	
67+82LT								2			24	2x12 METAL FARM ENTRANCE GATES (PARCEL 11)	
24+51.75LT	37+41.90LT	1,307										TIE TO EXISTING CROSS FENCE (PARCEL 12)	
27+39LT								1				SINGLE PANEL GALVANIZED STEEL SET IN CONCRETE (PARCEL 12)	
32+00LT								1				SINGLE PANEL GALVANIZED STEEL SET IN CONCRETE (PARCEL 12)	
36+25LT								2			20	2x10 METAL FARM ENTRANCE GATES (PARCEL 12)	
37+41.90LT									1			DOUBLE PANEL GALVANIZED STEEL SET IN CONCRETE (PARCEL 12)	
60+80.21RT	24+51.75LT								2	1		DOUBLE PANEL GALVANIZED STEEL SET IN CONCRETE (PARCEL 12)	
60+80.21RT	46+50RT			567								TIE TO EXISTING CROSS FENCE (PARCEL 12)	
25+00RT	37+42.50RT			1,247		3	3					STEEL POST AT 12' SPACING TIED TO SIDE FENCES (PARCEL 10)	
36+25RT						2					24	24' METAL FARM ENTRANCE GATE (PARCEL 10)	
68+19.71RT	69+05.00RT				85	2						TIE TO EXISTING FENCE (PARCEL 16)	
TOTAL		1,307		3,833	85	7	3	15	9		92		

- a. Changes to fencing stationing and quantity occurred. New stations and quantities are input in Excel with the font style mentioned above. If these were paper plans and as-builts were done by hand, these would simply be crossed out and the new stations and quantities written beside them.

UTILITY CASINGS					
STATION	linear feet		square feet	each	REMARKS
	STEEL CASING		INSULATION %%	END CAP #	
	16"	14" %	2" THK.		
651+50	114			2	INSULATION LT.
651+85	114			2	INSULATION LT.
680+25	94			2	INSULATION LT. & RT.
680+33	90			2	INSULATION LT. & RT.
683+91	88			2	INSULATION LT. & RT.
684+04	88			2	INSULATION LT. & RT.
0+55	90			2	ON COONEY ROAD
0+67	90			2	ON COONEY ROAD
SUBTOTAL	768			16	
TOTAL	768			~	

- b. Here is an example of an underground item that is not commonly seen on projects. Remember, any changes to or additional underground items need good detail.

SUBGRADE STABILIZATION *					
STATION		cubic yards		square yard	REMARKS
		UNCL. EXC.	SPECIAL BORROW - NEAT LINE	STABILIZATION GEOTEXTILE - HIGH SURVIVABILITY	
FROM	TO				
612+00.00 RT.	518+50.00 RT.		750.00		
606+52	608+57		197.41	296.1	CL AND LT.
607+17	608+27		81.48	122.2	LT.
608+57	612+49		653.33	653.3	CL AND LT.
610+52	612+83		323.33	485.0	CL AND LT
612+49	612+65		16.52		No Fabrice
612+45	612+81		26.67	40.0	CL.
613+27	615+71		277.11	406.7	CL AND LT.
613+35	613+81		54.52	81.8	CL.
618+11	617+76		38.89	58.3	LT.
619+63	623+13		207.41	311.1	CL AND LT.
622+90	623+45		55.56	83.3	CL AND LT
610+50.00 RT.	523+50.00 RT.		630.00	2200.0	GEOTEXTILE - 614+77 to 623+50 RT.
623+50.00 RT.	542+00.00 RT.		632.00		
642+00.00 RT.	548+00.00 RT.	731	1,709.00		
648+00.00 RT.	552+00.00 RT.		727.00		
652+94.21 RT.	555+03.43 RT.			587.4	DOWNSTREAM BERM
658+28	658+69		24.30	36.4	RT.
666+50	666+81		34.44	51.7	RT.
667+50	668+14		33.19	49.8	RT.
671+50	670+80		77.78	116.7	LT.
671+50	672+51		112.22	168.0	LT.
672+00	672+15		16.67	25.0	RT.
679+00	679+50		38.52		No Fabric
679+95	682+35		133.33		No Fabric
681+00	681+08		7.10		No Fabric
681+00	681+50		55.56	83.3	RT.
681+00	680+60		44.44	66.7	RT.
681+10	681+80		77.78	116.7	CL AND RT.
681+50	683+87		263.33	395.0	LT.
683+42	683+60		20.00	30.0	RT.
683+78	684+00		24.44	36.7	RT.
696+16	697+10		52.22	156.7	LT.
697+00	698+06		117.78	176.7	CL AND LT.
697+10	698+86		195.56	293.3	CL AND LT.
700+86	702+92		228.89	343.3	CL AND LT.
701+89	705+04		350.00	525.0	LT.
0+50.00	4+25.00	569	1,697.00	2855.3	COONEY ROAD
631+09 LT.				283.1	9 x 4 RCB
649+22 LT.				636.5	14 x 4 RCB
TOTAL		~	9,986.78	11,779.7	


- c. There were many changes to the subgrade stabilization. All changes and additions to this should be marked up to ensure they are drawn in the plan and profile accurately.

APPROACH PIPE (INCLUDED IN CULVERT SUMMARY RECAP)													
STATION	BASIC BID ITEMS			PIPE OPTIONS in				END SECTIONS		HEIGHT OF COVER	SKEW ANGLE	CULVERT IN PL. In x ft	REMARKS
	CULVERT PIPE in	linear feet		CONCRETE CLASS 3	STEEL - 2 2/3 x 1/2 CORR. 0.064 THK. #	ALUMINIUM - 2 2/3 x 1/2 CORR. 0.060 THK.	CORRU-GATED POLY-ETHYLENE PIPE	LEFT	RIGHT				
		LENGTH OF PIPE	REMOVE CULVERT										
274+89	18	66	49		1E			FETS	FETS	1.4		15 x 48.7 CMP	RT. DITCH
274+91	15	42	18	15 IRR				SQUARE	SQUARE	0.6		15 x 18.4 RCP	RCP IRR. LT BEYOND RAW LINE
274+91	18	56	36		1E			FETS	FETS	1.0		18 x 36.1 CMP	LT. DITCH
282+82	15	40	29	15 IRR				SQUARE	SQUARE				LT.
287+82	18	60	32		1E			FETS	FETS	2.7		15 x 32.2 CMP	LT. DITCH
287+92	18	62	33		1E			FETS	FETS	2.8		18 x 33.0 CMP	RT. DITCH
307+15			32									24 x 31.5 CMP	RT.
315+50	18	80			1E			FETS	FETS				RT.
325+50	18	40	40		1E			FETS	FETS	1.1			RT.
326+09			28									15 x 27.9 RCP	LT.
334+95	18	52	32		1E			FETS	FETS	2.1		18 x 32.1 CMP	RT.
335+73	18	40			1E			FETS	FETS	1.0			LT.
340+85	18	60	39		1E			FETS	FETS	4.1		18 x 39.4 CMP	RT.
TOTAL	~	~	359	~	~	~	~	~	~	~	~	~	~

CULVERT SUMMARY RECAP							
BASIC BID	linear feet		cubic yards				square yards
	NEW PIPE (TOTAL)	REMOVE PIPE CULVERT	FOUNDATION MATERIAL	GRANULAR BEDDING MATERIAL	CLASS GENERAL CONCRETE	RANDOM RIPRAP CLASS 1	STABILIZATION GEOTEXTILE
15" RCP IRR	82						
18" DR	576						
24" DR	528						
24" RCP IRR.	178						
24" RCP SIPHON	532						
30" RCP IRR.	100						
7' x 3' RCB	258						
84" DR	174						
TOTAL	~		1,528	377.42	264.30	18.40	~
							1,324.3

d. When completing approach pipe and culvert summaries, only include the option of pipe that was installed. Cross out or delete the other options that were not used. Remember to also update the "CULVERT SUMMARY RECAP" with totals from the other culvert summaries.

e. There are sometimes summaries included on other sheets outside of the actual summary sheets. Ensure these are updated as well.

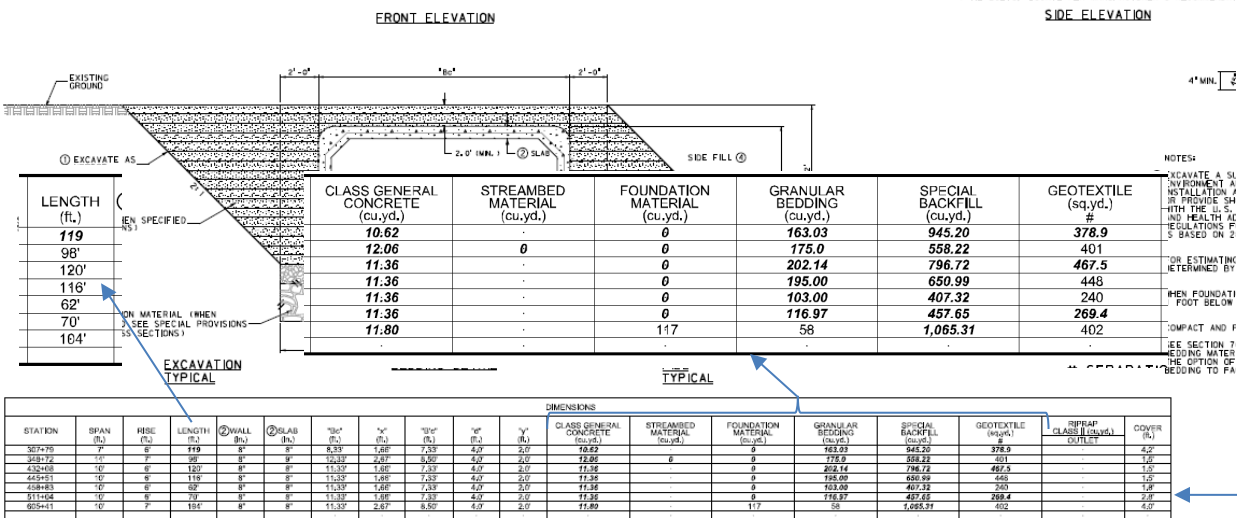


NOTE: INCLUDE REINFORCING MATERIAL, CUTOFF WALL, AND CONCRETE EDGE PROTECTION IN THE UNIT PRICE BID PER CUBIC YARD OF CLASS GENERAL CONCRETE. INCLUDE ANCHOR BELTS IN THE UNIT PRICE BID PER LINEAR FOOT OF CULVERT. PROVIDE BOX CULVERTS MEETING ASTM C1577. QUANTITIES ARE BASED ON THE DIMENSIONS IN THE TABLE.

SEPARATION/STABILIZATION - HIGH SURVIVABILITY

Procedure – As-Built Detail Sheet Information


1. Take time to go through each sheet and ensure all changes to plan are marked up accurately. Examples:

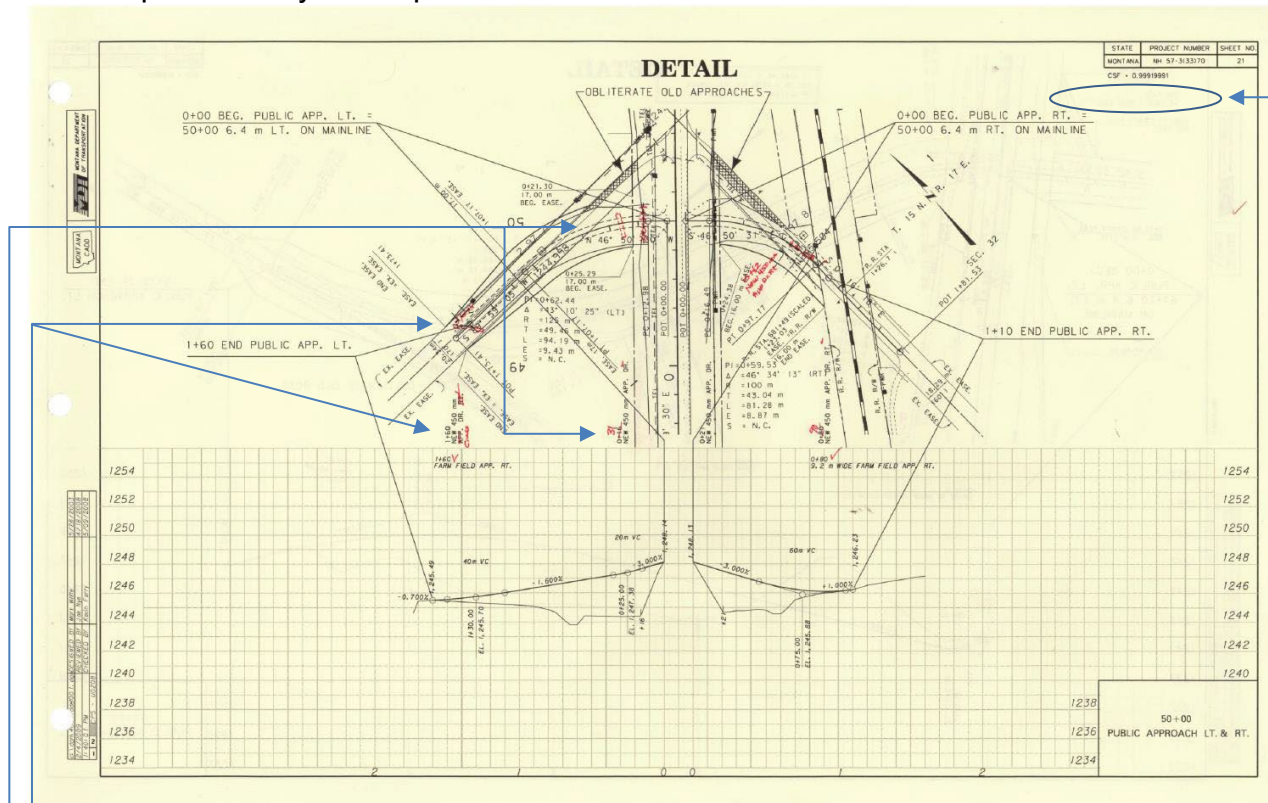



- a. An approach pipe was changed to a cross drain pipe. X out the original pipe that was not placed and draw in the new pipe. Remember to update the note above the profile view. Add the new pipe length to this as well.
- b. Approach drains were moved from plan stationing. Mark up in the same manner.

Note: This is an example of the older plan sheets that do not include the lower title box. If you do have plan sheets like this, add “AS-BUILTS” to the upper, right corner.


Note: If a station change occurred but was less than 5’, drawing the new pipe or other item is not necessary. Just update the stationing.

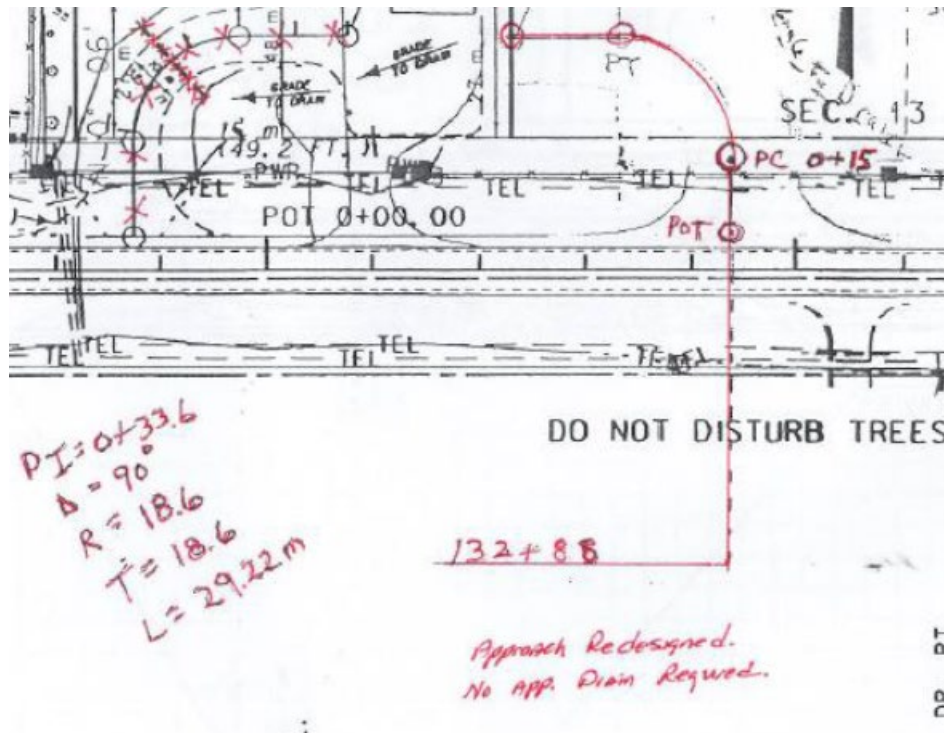


- c. A large approach was completely redesigned, and a pipe was omitted. Provide as much detail as possible.

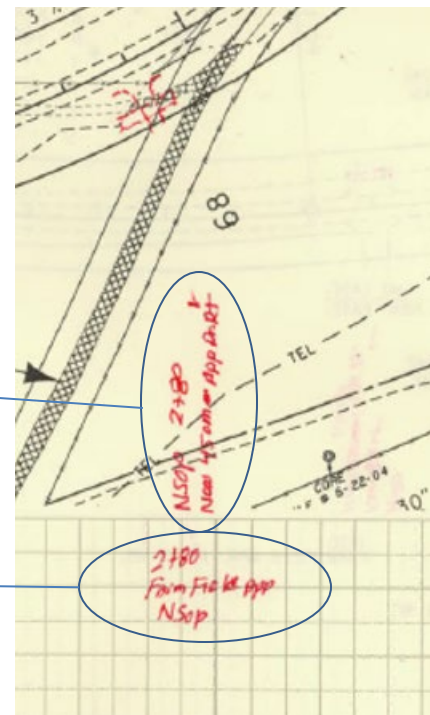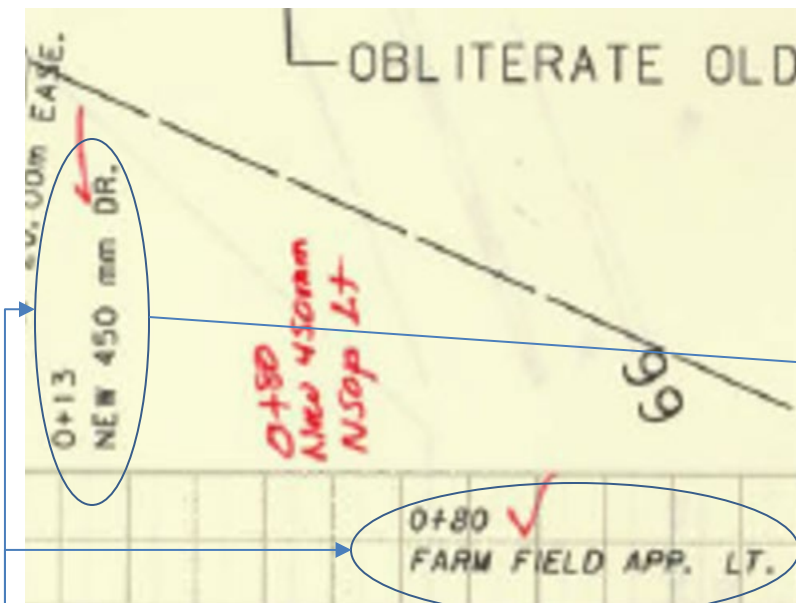

- d. An approach and pipe were added. Follow the same criteria as the designer did.

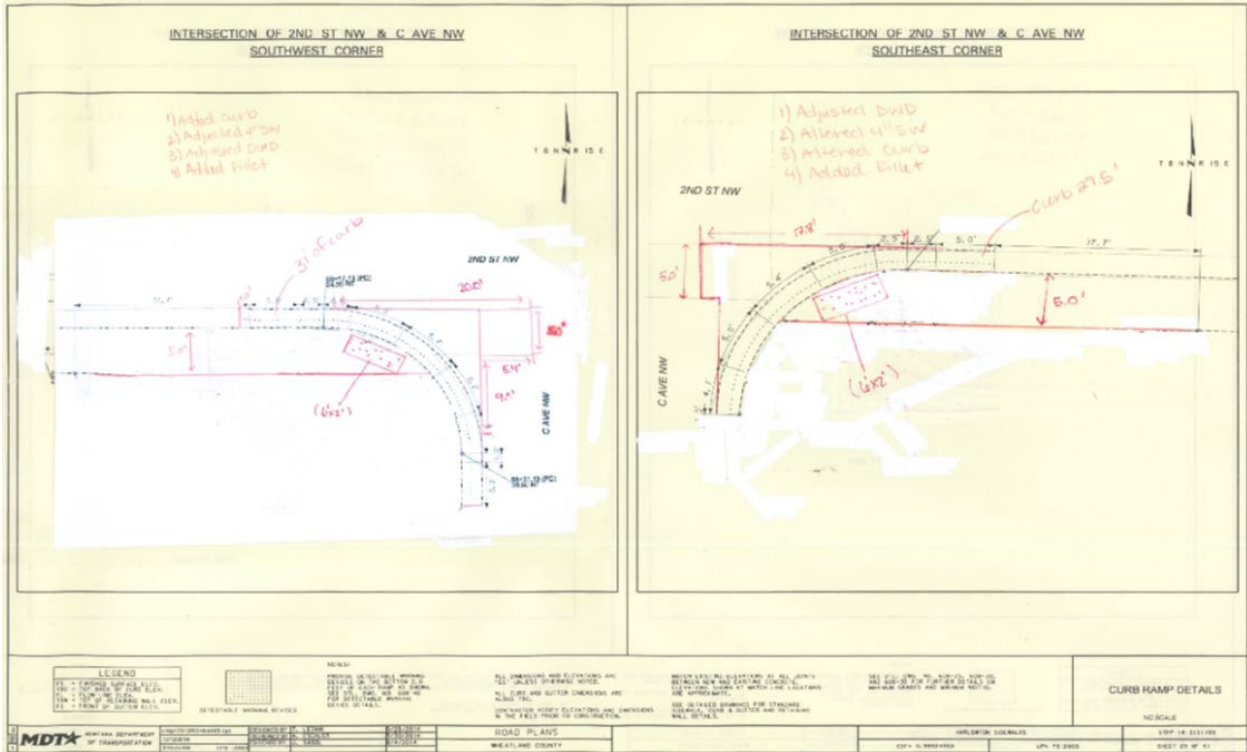


e. Changes to Curb, Gutter and Sidewalk occurred. Provide as much detail as possible including length, width, and radii if necessary.

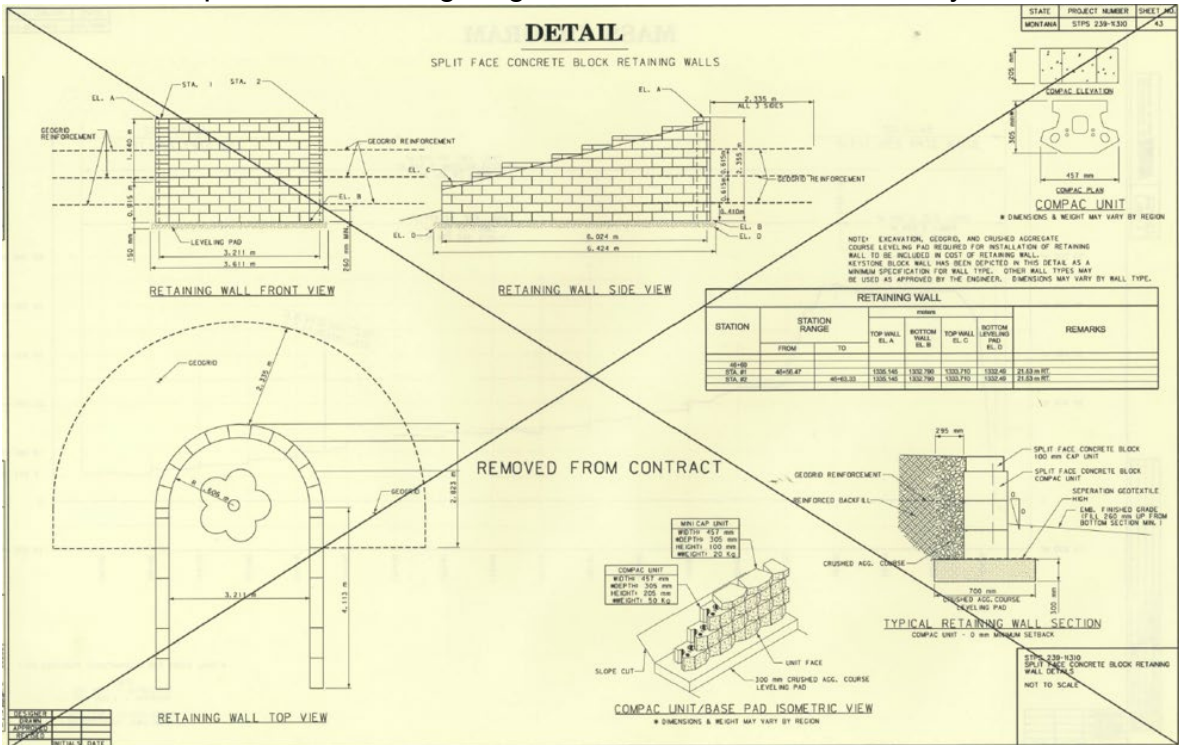


f. If you have details or other plan sheets that were not used, place an X through the specific detail or entire sheet.

Procedure – As-Built Plan and Profile Information


1. Plan and profile sheets are typically the most comprehensive and usually contain the most information in a road plan set. Take time to go through these sheet by sheet and update any changes. Ensure all callouts are correctly updated. Some sheets may have many changes while others have none. The important aspect is accuracy and thoroughness. Examples:

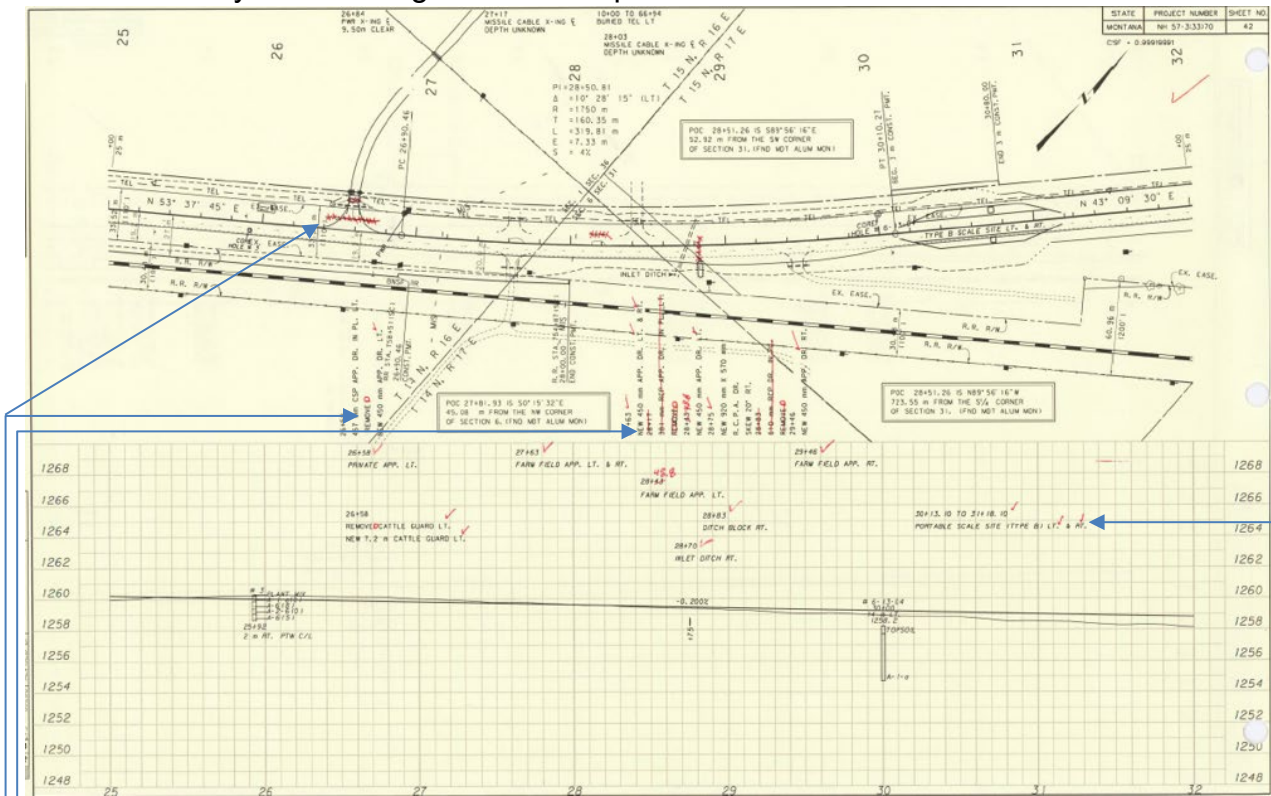


- a. If there are items planned for removal but are not there to be removed in the field, draw a line through the entire description and x out the item on the plan view.
- b. Any items that are removed per plan, add a “d” to the end of the “remove” (removed) and x out the item on the sheet.
- c. It is helpful to mark the unchanged items with a check so there is no question whether they were installed to plan. Ensure there is no conflicting information as this can complicate the as-built process when the DEO is building electronic as-builts from the crew’s redlined plans.

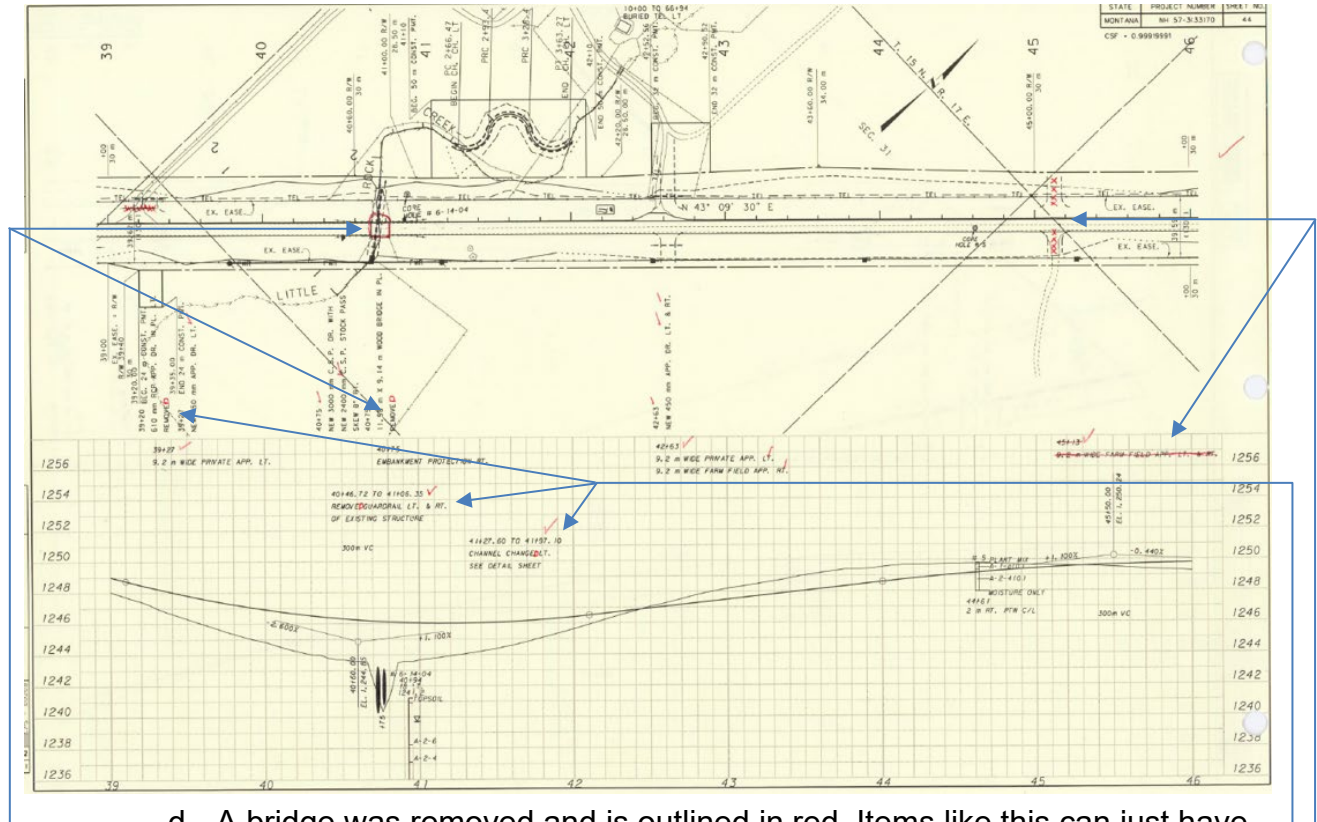

- d. A bridge was removed and is outlined in red. Items like this can just have an X placed through them and the “remove” changed to “removed”.
- e. Remember to change all text to past tense.
- f. These farm field approaches were not installed. X out the approaches and cross out the description.

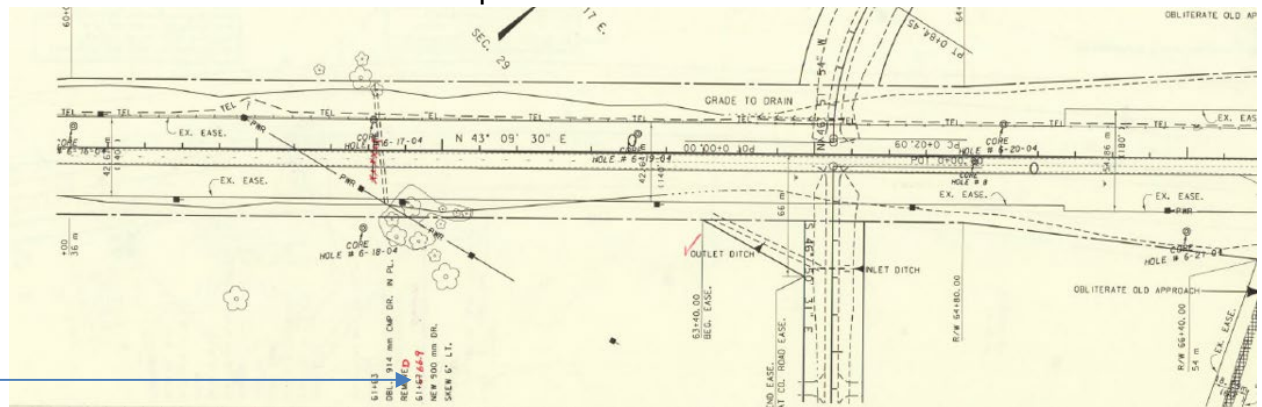


- g. A slight change was made to the stationing. Only the text needs to be corrected in instances like this.

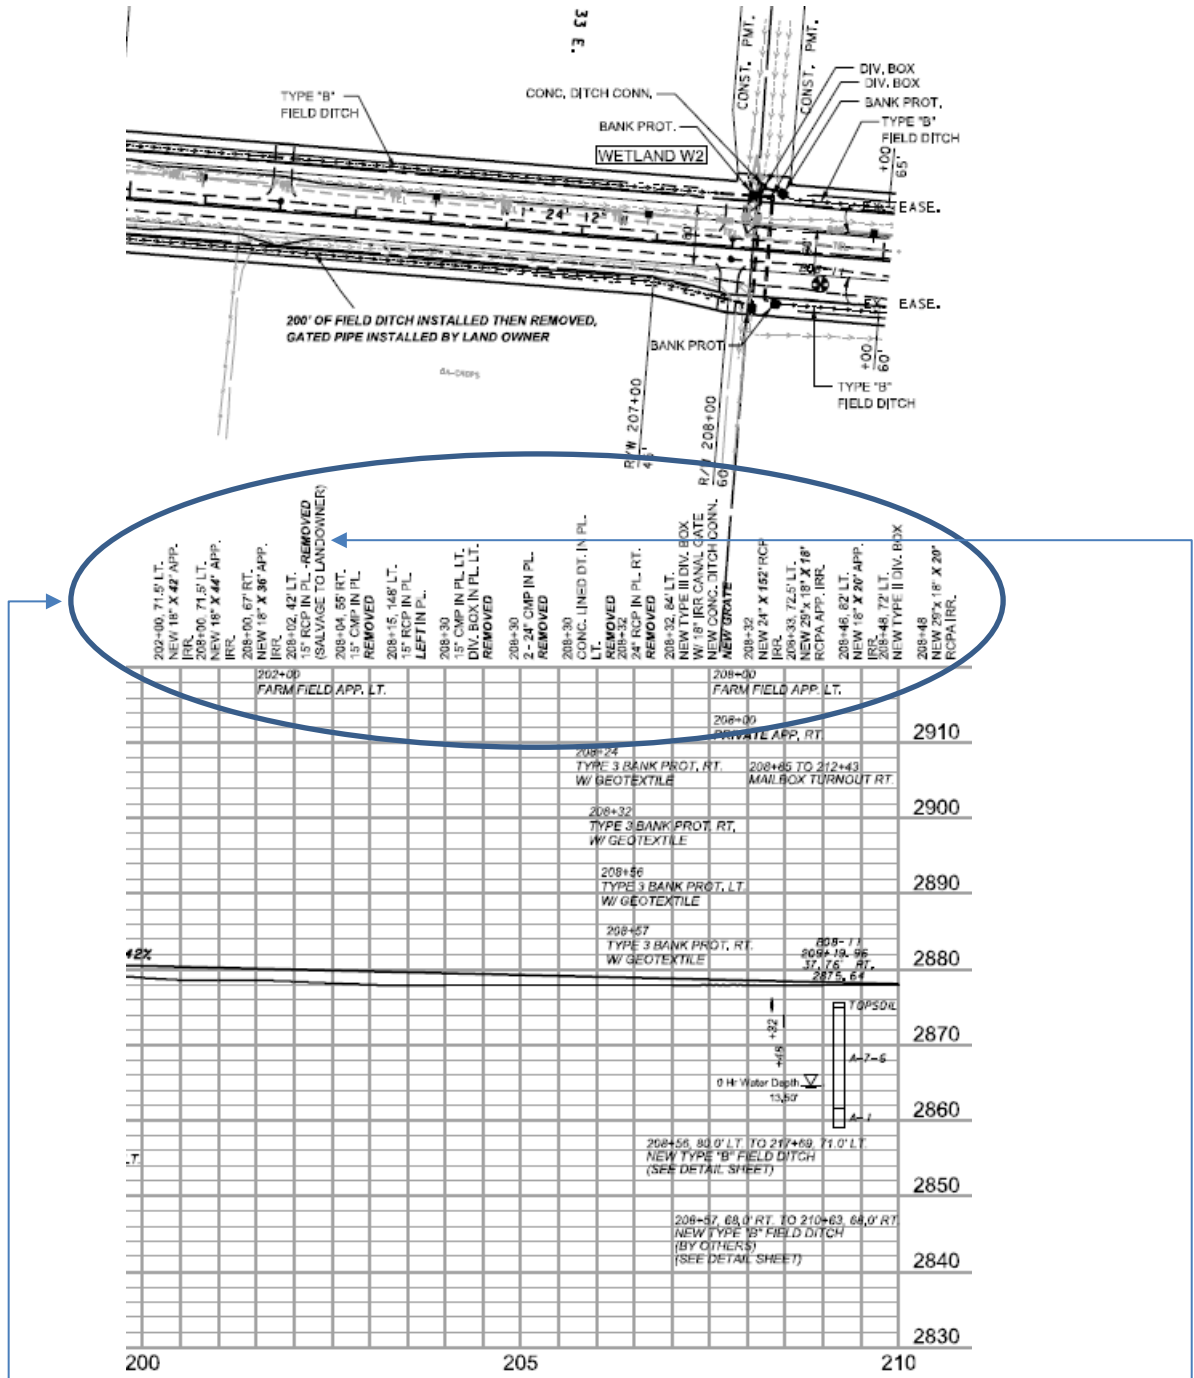


- h. This plan sheet has a lot of pipes. Ensure you go through each pipe and mark up any changes and changing all text to past tense. While doing this, add the pipe lengths. This sheet was completed in MicroStation, so the removed pipes were deleted, and the pipe lengths added in the text. When doing redlines, simply X out the removed pipes as mentioned before and add the pipe length next to the description above the profile view.

Note: The “SALVAGE” should have been changed to “**SALVAGED**”


Montana Department of Transportation - Construction Redline Edits for As-Built Plans

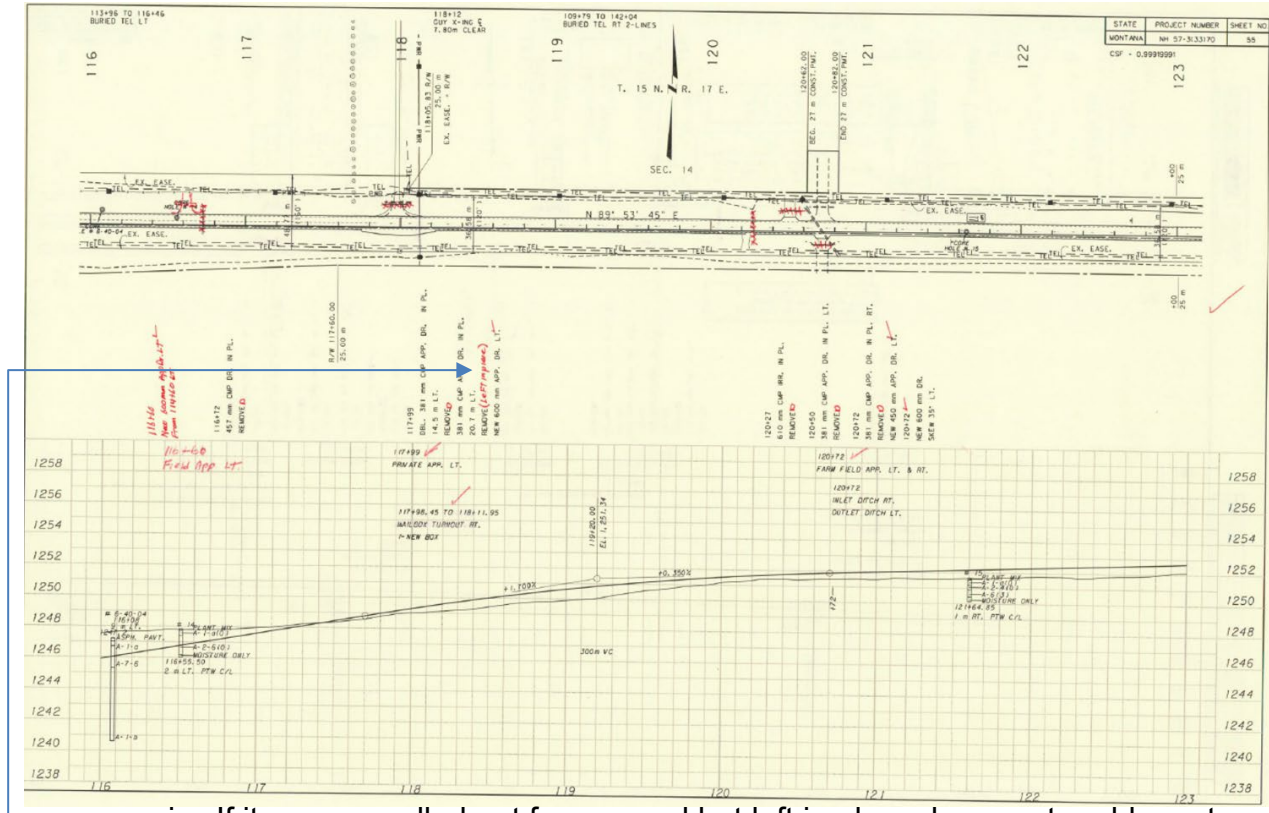


- i. If items are called out for removal but left in place, be sure to add a note so these items are not deleted when the MicroStation drawings are edited.

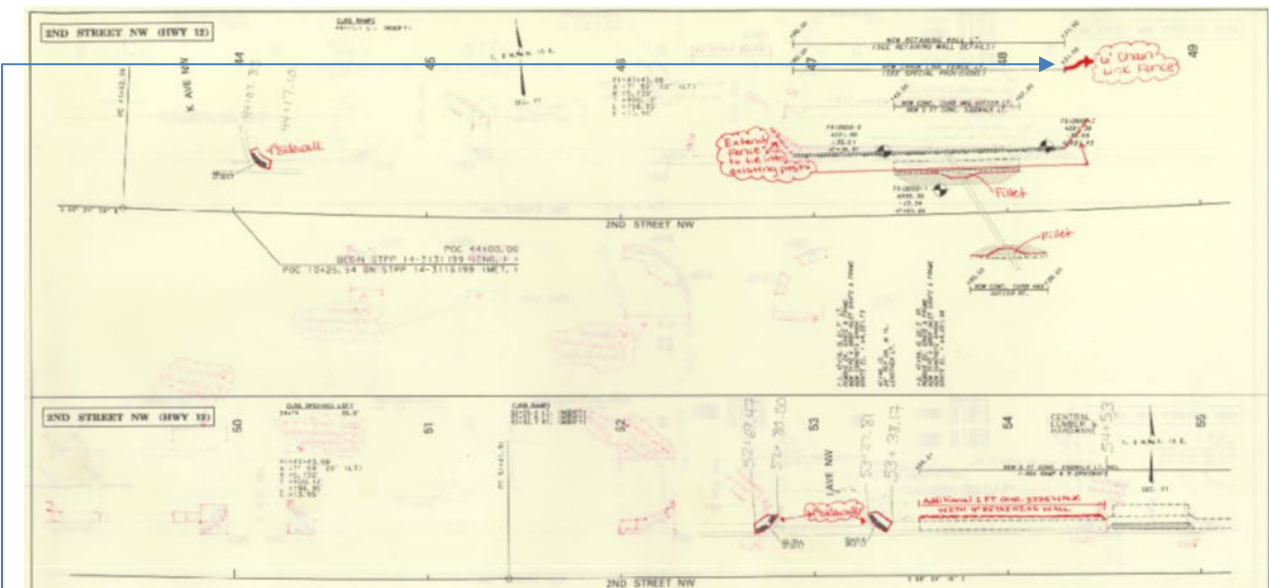

- j. Be sure to mark up all changes including fencing and guardrail.

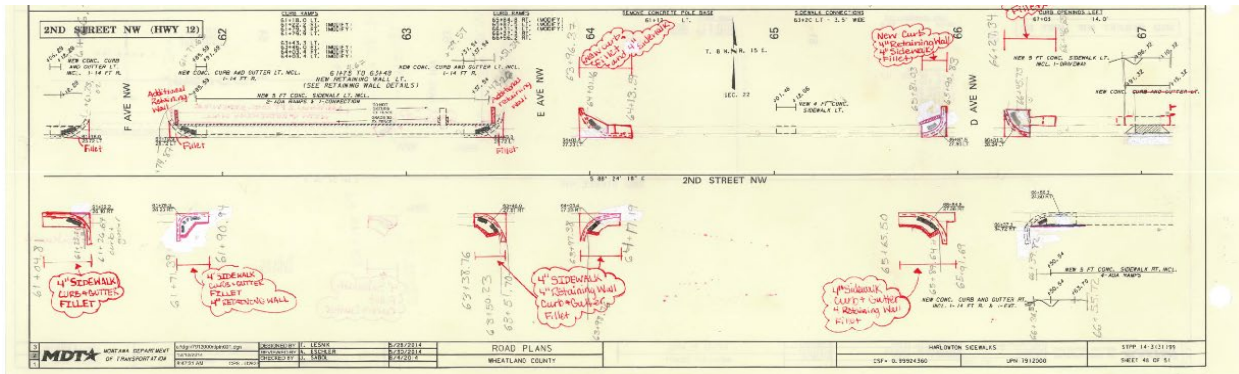

- k. Include any changes to curb, gutter, and sidewalk including stationing changes and detectable warning device location changes. Specific lengths and widths are shown in more detail in their respective detail sheets.

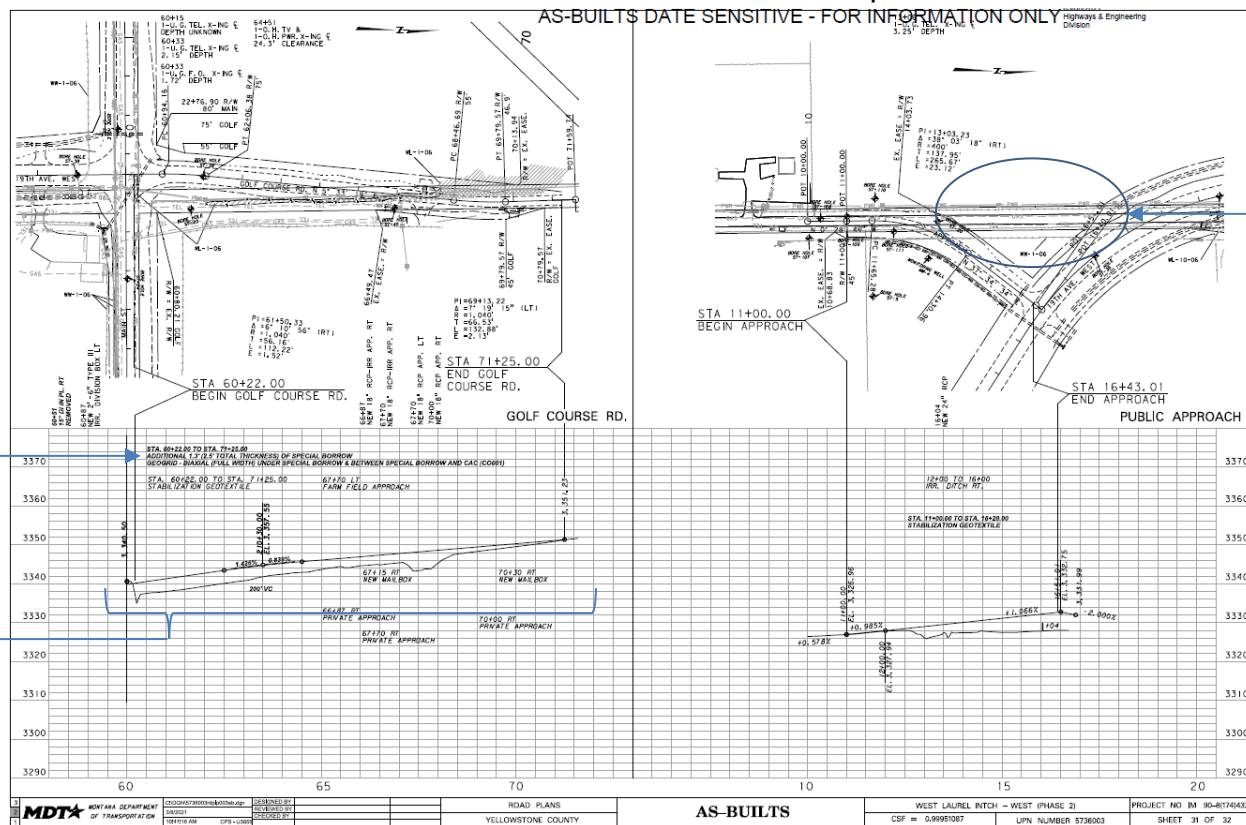

- l. Any grade changes that occur need to be documented. Be specific as to what the grade change was and where from/to it occurred.
- m. Additional geogrid/geotextile, special borrow, etc. should be noted on the plan and profile as well.
- n. Obliterated alignments are completely removed while editing in MicroStation. When marking these up on existing plans, X out the alignments that have been obliterated.

Procedure – As-Built Signing Plans Information

- Update the summaries to reflect project quantities and information. Signing summaries are typically broke up into two sections, “SIGNING AND DELINEATION QUANTITIES” and “SIGN LOCATION AND SPECIFICATIONS”. The former is a grand total for each bid item on the project. This usually only contains one column for totals. On some projects with multiple locations, each location will be broken out and then a total is included on the far right. The project used below is an example of this. If separate locations are broken out, ensure totals for each location are updated as well as the total for the entire project. The latter shows the specifics for each sign. Every change to any sign should be marked here.


SUMMARY SIGNING & DELINEATION QUANTITIES										TOTAL	UNIT
MATERIAL	KING AVE E SITE #1	YELLOWSTONE RIVER RD SITE #2	LAKE ELMO DR SITE #3	COONEY RD SITE #4	COUNTRYMAN CR RD SITE #5	SO. FRONTAGE RD SITE #6	GARDEN AVE SITE #7	NAHMIS AVE SITE #8	STORY RD SITE #9		
SIGNS-SHEET ALUMINUM-REFLECTIVE SHEETING(IV)	48.0						76.6			124.6	SQ. FOOT
SIGNS-SHEET ALUMINUM-REFLECTIVE SHEETING(XI)	194.2	81.2	29.2	63.2	67.2	57.2	334.8		57.2	884.2	SQ. FOOT
SIGNS-ALUMINUM SHEET INCREMENT SHEETING (IV)											SQ. FOOT
SIGNS-ALUMINUM SHEET INCREMENT SHEETING (XI)							42.0			42.0	SQ. FOOT
OVERLAY-SHEET ALUMINUM											SQ. FOOT
POSTS-STEEL "U"			80				20			100	POUNDS
POLES-TREATED WOOD-4" DIA.	148	112		94	98	84			72	944	LINEAR FT.
POLES-TREATED WOOD-5" DIA.	32						112			144	LINEAR FT.
POLES-TREATED TIMBER-CLASS 4											LINEAR FT.
POLES-TREATED TIMBER-CLASS 3											LINEAR FT.
POSTS-TUBULAR STEEL (ROUND)											POUNDS
POSTS-TUBULAR STEEL (SQUARE PERFORATED)			126							126	POUNDS
POSTS-STRUCTURAL STEEL											POUNDS
OVERHEAD STRUCTURE-METAL-CANTILEVER											EACH
OVERHEAD STRUCTURE-METAL-BRIDGE											EACH
HIGHWAY TRAFFIC STRIPING-WHITE		14	14							28	GALL(S)
HIGHWAY TRAFFIC STRIPING-YELLOW											GALL(S)
WORDS & SYMBOLS											GALL(S)
DELINEATOR-DESIGN A			4					20		24	EACH
DELINEATOR-DESIGN B											EACH
DELINEATOR-DESIGN C			20					14		34	EACH
DELINEATOR-DESIGN D			0					6		14	EACH
DELINEATOR-DESIGN E											EACH
DELINEATOR-DESIGN F								12		12	EACH
DELINEATOR-DESIGN G											EACH
DELINEATOR-DESIGN H											EACH
REMOVE SIGNS	33	6	6	2	2	4	39		2	94	EACH
REMOVE SIGNS-GUIDE	2	2		2		1	4			11	EACH
RESET SIGNS											EACH
RESET SIGNS-GUIDE											EACH
FRANGIBLE SIGN POST BREAKAWAY DEVICE-											EACH
FRANGIBLE SIGN POST BREAKAWAY DEVICE-											EACH
SQUARE TUBULAR SLIPBASE BREAKAWAY DEVICE-3"											EACH

- On this project, multiple locations are broken out in their own separate column. Ensure to update each site’s total for each bid item.
- Once each location is updated, update the project total in its respective column. Most projects will only have this column.
- Check marks next to items that match plan are helpful when trying to determine if there were any changes to a total or item.


SIGN LOCATION AND SPECIFICATIONS																												
LOCATION	SHEET NO.	PANEL SIZE	REFL. SHEET TYPE	FEET	FEET	FEET	SIGN PANEL (SQ. FT.)	TIMBER POLE (LINEAR FT.)				STEEL POST (LBS.)				SHEETING				REMARKS								
								WOOD POST	STEEL POST	STEEL POST	STEEL POST	STEEL POST	STEEL POST	STEEL POST	STEEL POST	STEEL POST	STEEL POST	STEEL POST	STEEL POST		STEEL POST	STEEL POST	STEEL POST					
LOCATION	STATION	POST NO.	REFL. SHEET TYPE	FEET	FEET	FEET	SIGN PANEL (SQ. FT.)	WOOD POST	STEEL POST	STEEL POST	STEEL POST	STEEL POST	STEEL POST	STEEL POST	STEEL POST	STEEL POST	STEEL POST	STEEL POST	STEEL POST	STEEL POST	STEEL POST	STEEL POST	STEEL POST	STEEL POST	STEEL POST	STEEL POST	STEEL POST	
SITE #7 - GARDEN AVE																												
LOCATION 1 RT	1200-3	42118	IV	6-0	3'-Dia	14-0	30.8-17																					
LOCATION 2 RT	W99-1	30330	XI	6-0	3'-Dia	14-0	30.8-17																					
LOCATION 3 RT	W99-1	30330	REMOVE																									
LOCATION 4 RT	W1-7a	72422	XI	15-0	3'-Dia	14-0	21.0-11																					
LOCATION 5 RT	W1-2b	24130	XI																									
LOCATION 6 RT	W16-1	30330	XI																									
LOCATION 7 LT	1200-3	42118	IV	6-0	3'-Dia	14-0	30.8-17																					
LOCATION 8 RT	W1-11	30330	XI	10-0	3'-Dia	14-0	30.8-17																					
LOCATION 9 RT	1200-3	42118	XI	10-0	3'-Dia	14-0	30.8-17																					
LOCATION 10 RT	1200-3	42118	XI	10-0	3'-Dia	14-0	30.8-17																					
LOCATION 11 RT	1200-3	42118	XI	10-0	3'-Dia	14-0	30.8-17																					
LOCATION 12 RT	1200-3	42118	XI	10-0	3'-Dia	14-0	30.8-17																					
LOCATION 13 RT	1200-3	42118	XI	10-0	3'-Dia	14-0	30.8-17																					
LOCATION 14 LT	W1-1R	30330	XI	10-0	3'-Dia	14-0	30.8-17																					
LOCATION 15 LT	W14-1a	30330	XI																									
LOCATION 16 RT	W1-11	30330	XI	6-0	3'-Dia	14-0	30.8-17																					
LOCATION 17 RT	1200-3	42118	XI	10-0	3'-Dia	14-0	30.8-17																					
LOCATION 18 RT	1200-3	42118	XI	10-0	3'-Dia	14-0	30.8-17																					
LOCATION 19 LT	W1-11	30330	XI	10-0	3'-Dia	14-0	30.8-17																					
LOCATION 20 RT	W1-11	30330	XI	10-0	3'-Dia	14-0	30.8-17																					
LOCATION 21 LT	1200-3	42118	XI	10-0	3'-Dia	14-0	30.8-17																					
LOCATION 22 LT	1200-3	42118	XI	10-0	3'-Dia	14-0	30.8-17																					
LOCATION 23 LT	1200-3	42118	XI	10-0	3'-Dia	14-0	30.8-17																					
LOCATION 24 LT	W1-11	30330	XI	10-0	3'-Dia	14-0	30.8-17																					

STANDARD BREAKAWAY DEVICE:
 -FOR WOOD POST SEE
 DETAILED DRAWING 619-20.
 -FOR STRUCTURAL STEEL SEE
 DETAILED DRAWING 619-13.
 FY = TYPE XI FLUORESCENT YELLOW
 SHEETING REQUIRED.

- d. Several signs were added. Include all information for each sign following the same criteria as the designer.
- e. Update the post length to match the placed quantity (calculated on signing spreadsheet).
Note: The "SUPPORT LENGTH (INSTALLED)" is optional but if this is filled out, this should be the actual length of the post (Ex.: Wood posts are rounded to the next 2' of length for placed quantity, but a 14' paid post may only be 12.5'. This column would have the 12.5' while the "TIMBER POLE (LINEAR FT.)" column would contain the 14').
- f. Ensure the type of sheeting is noted and in its correct column.
- g. Remember to change any text to past tense ("REMOVE" to "REMOVED", "REPLACE" to "REPLACED", etc.). This was missed while completing these as-builts. Doing this helps make it easy to know a sign was removed or replaced according to plan.

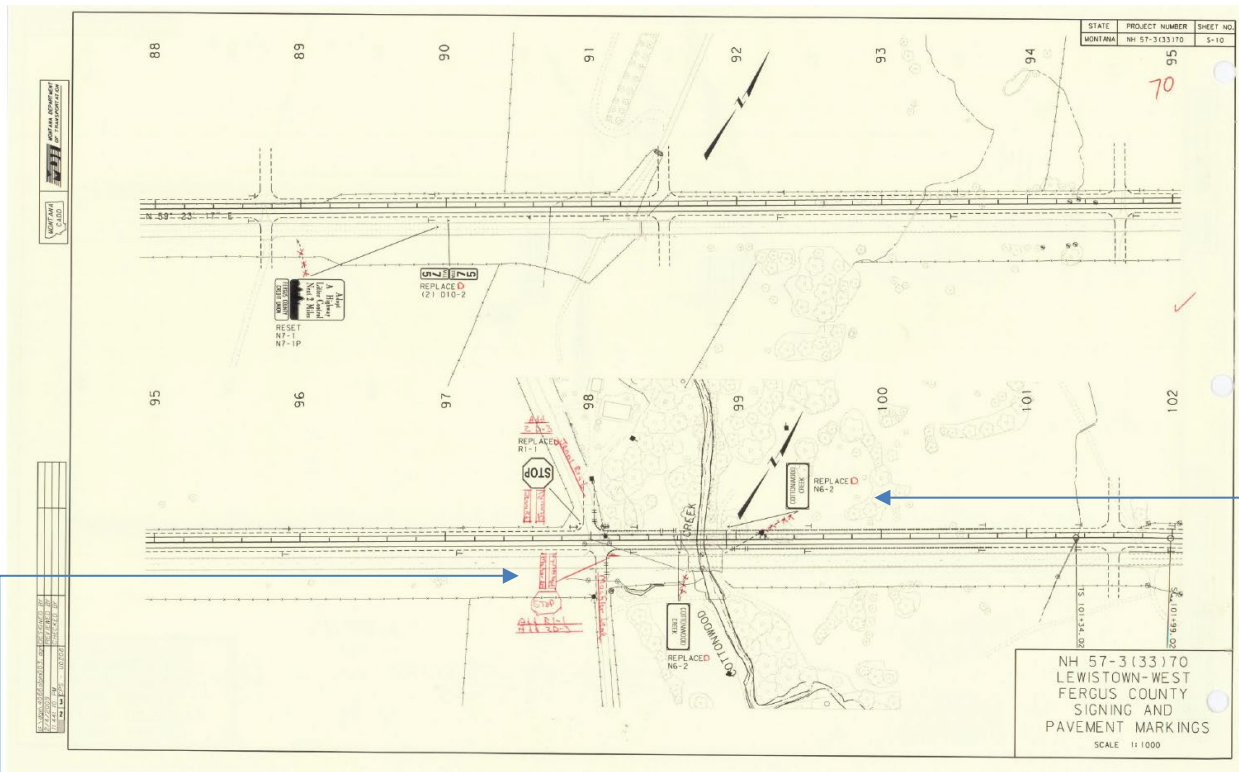

- d. New signs were added. Be sure to include the sign number and legend.
- e. When a sign is being replaced there are typically 2 lines on the plans. One to the old location and one to the new. When redlining these, X out the old location line. Also remember to add a "D" to "REPLACE".

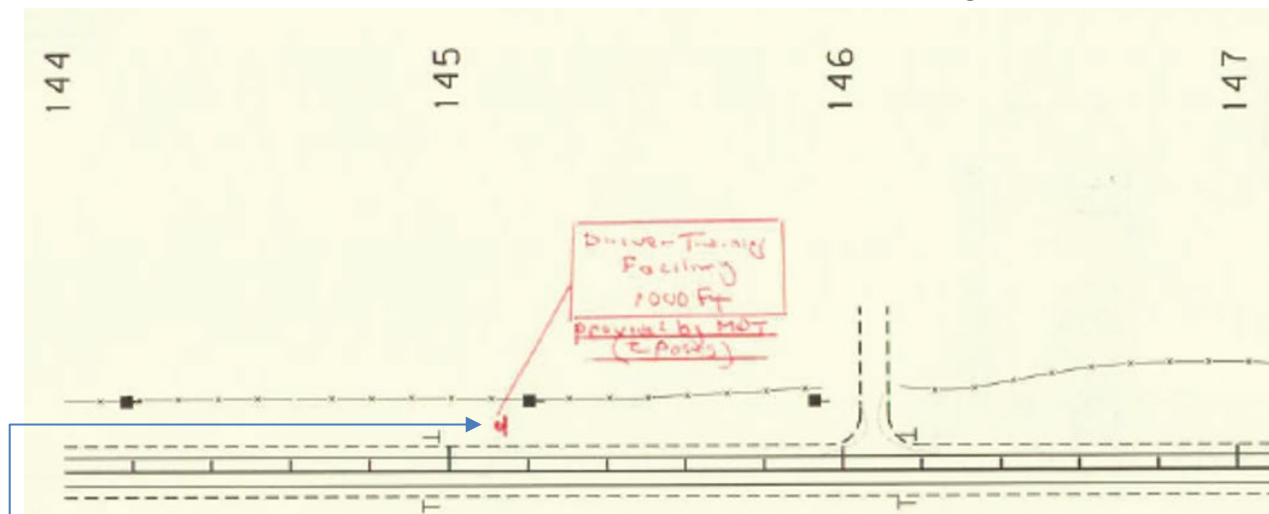

- f. When adding NSOP signs, pay attention to the way they are drawn in. The small circle is the post, and the line represents the sign face. Make sure the sign is facing the correct direction so there is no confusion.

Procedure – As-Built Electrical Plans Information

Note: Electrical as-builts need to be very accurate. Most electrical is underground and MDT designs all of the electrical plans for projects in-house. Accurate as-builts are crucial to the success of projects being designed in the future as well as maintenance after electrical systems are installed.

1. Update the electrical summary with totals for the project.

AS-BUILTS DATE SENSITIVE - FOR INFORMATION ONLY

ELECTRICAL QUANTITY SUMMARY

ITEM NO.	MATERIAL	UNIT	TOTAL	BY	DATE
ELT 010 000	FOUNDATION - CONCRETE	M	1.000	JAN	7/26/07
ELT 020 000	CONDUIT - PLASTIC 3/4"	M	30.000	APR	7/27/07
ELT 030 000	PULL BOX - CONCRETE TYPE 1	EACH	4	JUN	7/27/07
ELT 040 000	PULL BOX - CONCRETE TYPE 2	EACH	3	JUN	7/27/07
ELT 050 000	CABLE - COPPER 14/2-100' X 4	LINEAR METER	2000.0	APR	7/27/07
ELT 060 000	CABLE - COPPER 14/2-100' X 4	LINEAR METER	2000.0	APR	7/27/07
ELT 070 000	CONDUIT 1/2" X 1/2"	M	2000.0	APR	7/27/07
ELT 080 000	CONDUIT 1/2" X 1/2"	M	2000.0	APR	7/27/07
ELT 090 000	CONDUIT 1/2" X 1/2"	M	2000.0	APR	7/27/07
ELT 1000 000	CONDUIT 1/2" X 1/2"	M	2000.0	APR	7/27/07

* - INDICATES STATE FURNISHED MATERIAL

AS-BUILTS

TYPE 1	TYPE 2	TYPE 3
L = 485 mm	L = 541 mm	L = 830 mm
W = 321 mm	W = 413 mm	W = 500 mm
D = 300 mm	D = 300 mm	D = 300 mm
1/2 L = 242 mm	1/2 L = 270 mm	1/2 L = 415 mm
1/2 W = 160 mm	1/2 W = 206 mm	1/2 W = 250 mm
C L = 181 mm	C L = 233 mm	C L = 415 mm
C W = 229 mm	C W = 300 mm	C W = 400 mm

NOTE: WHEN REPLACING AN EXISTING PULL BOX, ADJUST CONDUIT STUB HEIGHT ACCORDINGLY.

FLOWABLE FILL FOR TRENCHES

FURNISH FLOWABLE FILL IN ACCORDANCE WITH THE SPECIAL PROVISIONS. IF A SPECIAL PROVISION IS NOT PROVIDED, FURNISH FLOWABLE FILL MEETING SUBSECTION 501.02.02 OF THE STANDARD SPECIFICATIONS FOR ROAD AND BRIDGE CONSTRUCTION, 2006 EDITION.

NOTE - COLD MIXED ASPHALT MAY BE USED FOR A TEMPORARY PATCH IF HOT MIX ASPHALT IS NOT AVAILABLE. USE 100 MP OF HOT ASPHALT FOR THE PERMANENT PATCH. CUT EXISTING ASPHALT 25 mm BEYOND TRENCH AND APPLY A TACK COAT PRIOR TO INSTALLING THE PERMANENT PATCH.

ELECTRICAL DETAIL DRAWING

QUANTITY SUMMARY


PULL BOX CONCRETE TYPE I & II

NON-SHRINK BACKFILL

NO SCALE

- Electrical summaries only require totals for the project. This summary was edited in MicroStation. If redlining a summary, simply cross out the original quantity and write in the correct quantity.

2. Update the electrical plan sheets to reflect any field changes.

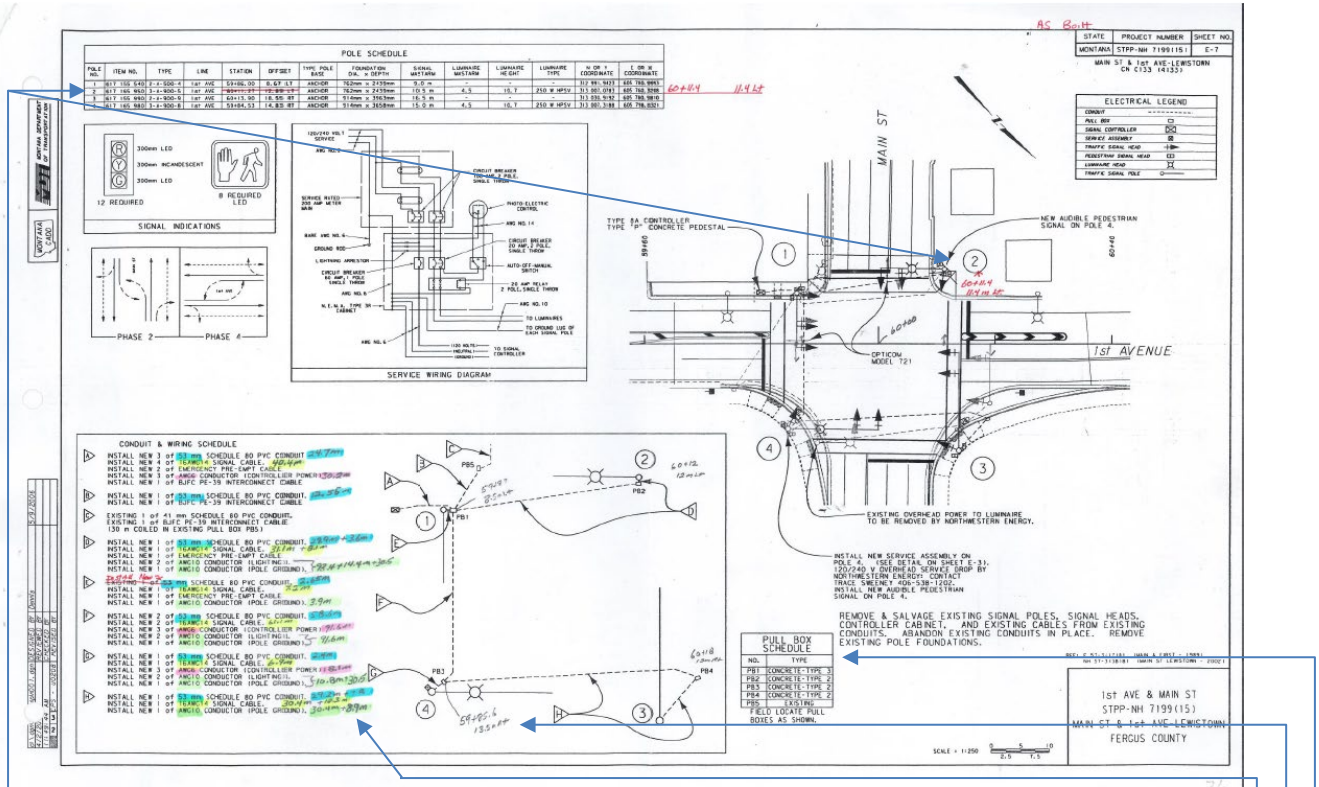

- The pole schedule needs to be updated with any changes including pole types, luminaires, locations, etc. On this set, the station and offset were changed. Also note location changes in the plan view.
- In the conduit and wiring schedule, the person completing these redlines added a length for each run. This is not required but is helpful. On some projects this may not work since the letters may be used multiple times on the same sheet and can get cramped trying to fit it all in but can be noted next to each run in the diagram. Any changes to wiring or conduit including type or amount needs to be shown here.
- Pull box stations and offsets need to be included for as-builts. Conduit/wire routing locations should also be updated if they are different than plan location. This is typically just pull box to pull box but any variance between needs to be marked up. This person marked a station and offset for each pull box making it very easy for the person completing the MicroStation drawings to update any that were moved from plan.
- The pull box schedule also needs to be updated to reflect any changes made in the field. Some recent plans have come out that do not include these and do not label pull boxes. Add or update these as necessary.

Procedure – As-Built Bridge Plan Information

1. Update bridge plan sheets to reflect any changes made in the field.

AS-BUILTS DATE SENSITIVE - FOR INFORMATION ONLY

MONTANA DEPARTMENT OF TRANSPORTATION

BRIDGE PLANS AND QUANTITIES
FEDERAL AID PROJECT IM 90-8(174)432
WEST LAUREL INTCH - WEST (PHASE 2)
YELLOWSTONE COUNTY
AS-BUILTS

LIST OF DRAWINGS


SHEET NO.	DWG. NO.	TITLE
BRIDGE DRAWINGS		
B1	227410	QUANTITIES & FINAL TIP ELEVATIONS
B2	22741	GENERAL LAYOUT AT STA. 214+67.80
B3	22742	FOOTING PLAN
B4	22743	BENT NO. 1 & NO. 3
B5	22744	BENT NO. 1 & NO. 3 DETAILS
B6	22745	BENT NO. 2
B7	22746	BENT NO. 2 DETAILS
B8	22747	ERECTION PLAN
B9	22748	SLAB DETAILS
B10	22749	SLAB AND BARRIER DETAILS
STANDARD DRAWINGS		
PSD (APPROVED 1-30-15)		STANDARD PILE SPlice DETAILS AND PILE TIPS
MTS (REVISED 5-20-14)		STANDARD PRESTRESSED CONCRETE BEAM TYPE MTS
SLAB (REVISED 3-15-17)		STANDARD SLAB AND DIAPHRAGM DETAILS
SBR-6RR (REVISED 3-15-17)		STANDARD BRIDGE RAIL TYPE BARRIER


LOCATION BRIDGE I.D. 07026 STA. 214+67.80	PILE 1 FINAL TIP ELEVATION	PILE 2 FINAL TIP ELEVATION	PILE 3 FINAL TIP ELEVATION	PILE 4 FINAL TIP ELEVATION	PILE 5 FINAL TIP ELEVATION	PILE 6 FINAL TIP ELEVATION	PILE 7 FINAL TIP ELEVATION
BENT NO. 1	3,266.18	3,265.70	3,265.84	3,266.00	3,266.50	3,266.50	3,266.50
BENT NO. 2 LT	3,265.31	3,265.11	3,265.73	3,267.40	3,267.40	3,267.80	N/A
BENT NO. 2 CL	3,265.31	3,264.31	3,265.33	3,266.40	3,266.70	3,266.70	N/A
BENT NO. 2 RT	3,264.71	3,263.91	3,265.80	3,266.40	3,266.57	3,266.60	N/A
BENT NO. 3	3,268.60	3,268.80	3,267.80	3,268.80	3,268.50	3,268.80	3,267.00

LOCATION BRIDGE I.D. 07026 STA. 214+67.80	LENGTH IN FEET	TEMPORARY SHORING NOT USED (LLMP SUM)	STRUCTURE EXCAVATION TYPE 1 (YD ³)	CONCRETE - CLASS STRUCTURE (YD ³)	"CONCRETE - CLASS STRUCTURE LOW SLUMP (YD ³)"	ARCHITECTURAL TREATMENT (YD ²)	PRESTRESSED BEAM - TYPE MTS-54 (FT)	REINFORCING STEEL REGULAR (LB)	EPOXY COATED (LB)	SEISMIC (LB)	RE-DRIVE TEST PILE NOT USED (EACH) (FT)	HP 14 X 89 STEEL PILE FURNISH (FT)	DRIVE (FT)	DYNAMIC LOAD TEST (EACH) (EACH)	PILE DRIVING POINT (EACH) (EACH)	POLYMER OVERLAY NOT USED (YD ²)	PREPARE DECK NOT USED (YD ²)	BARRIER RAIL CAST IN PLACE - BR (FT)
BENT NO. 1				54.20	2.30			4,002	1,178			572	925	1	7			
BENT NO. 2			135.00	109.00	2.30			21,028		514		852	842	1	18			
BENT NO. 3				84.20	2.30			4,002	1,178			918	457	1	7			
SUPERSTRUCTURE	242		28.20	384.70	107.5		1,684	75,464		614	0	1,002	1,824	3	32	0.0	0.0	489
TOTAL	242	0.000	135.00	246.60	380.30		107.5	20,032	77,826	614	0	1,002	1,824	3	32	0.0	0.0	489


* CONG CHANGED CONCRETE - CLASS DECK TO CONCRETE - CLASS STRUCTURE LOW SLUMP

- Update the bridge quantity summary. This is labeled as "ESTIMATED BRIDGE PLAN QUANTITIES". Once the quantities are updated, this will be labeled as "AS-BUILT BRIDGE PLAN QUANTITIES".
- Final pile tip elevations need to be included on bridge as-builts. These can be added on the title page or on the page depicting pile driving information (typically the footing plan sheet). Label the piles to correspond with the pile tip elevation table.
- Update the "LIST OF DRAWINGS" if anything is added or changed. The final pile tip elevation table was added to the list on this example.

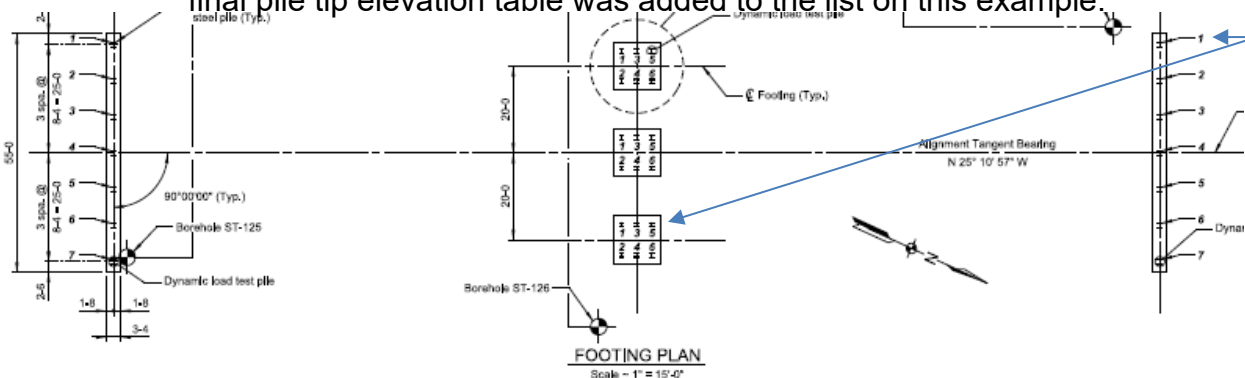

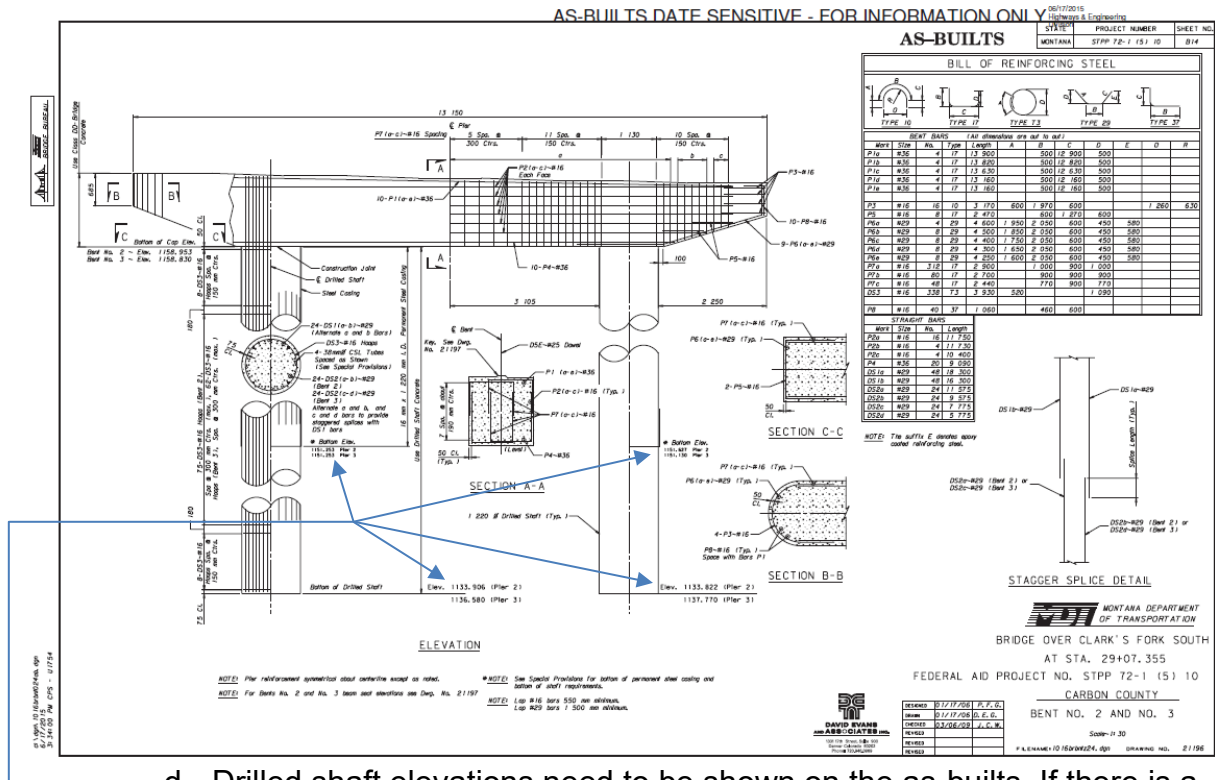

d. Drilled shaft elevations need to be shown on the as-builts. If there is a permanent casing, show these elevations as well.

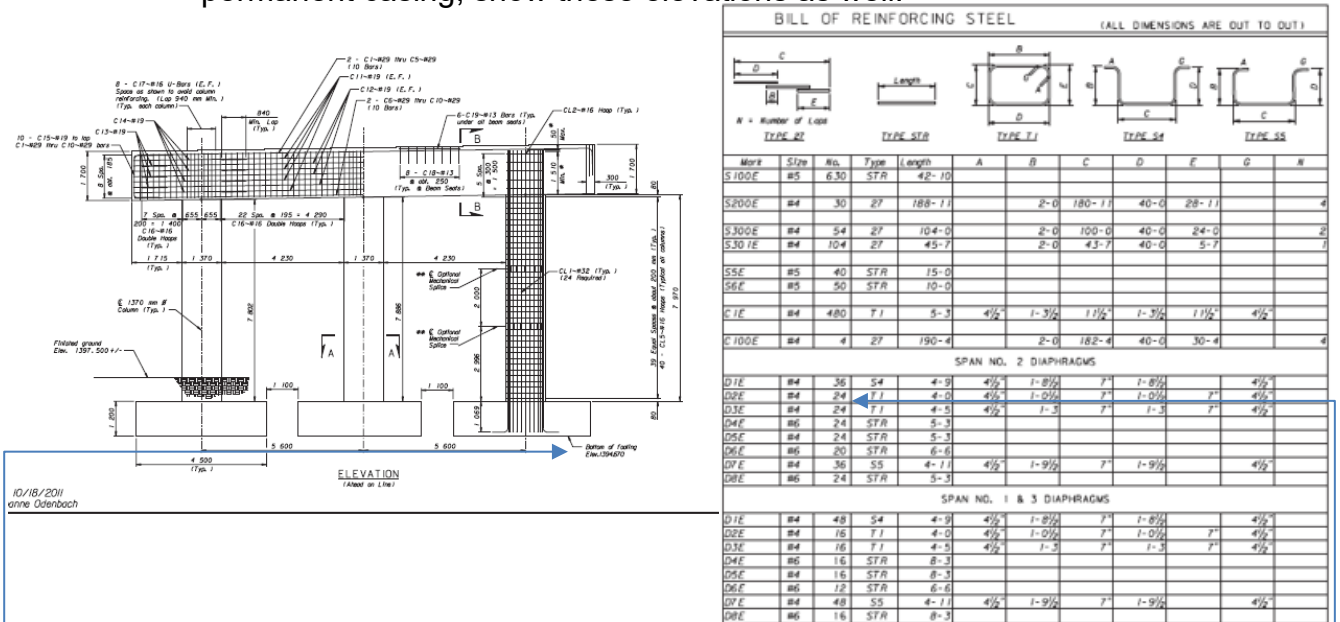

e. Mark up any changes to sheets. The footing elevation was changed in the field. If marking up by hand, just X out the existing and write in the new.

f. Rebar was changed in this "BILL OF REINFORCING STEEL".

Note: Bridges are typically built very close if not virtually identical to plan, but any changes need to be noted accurately.

Procedure – As-Built Cross Section Information

1. Cross Sections are not required for as-builts.

