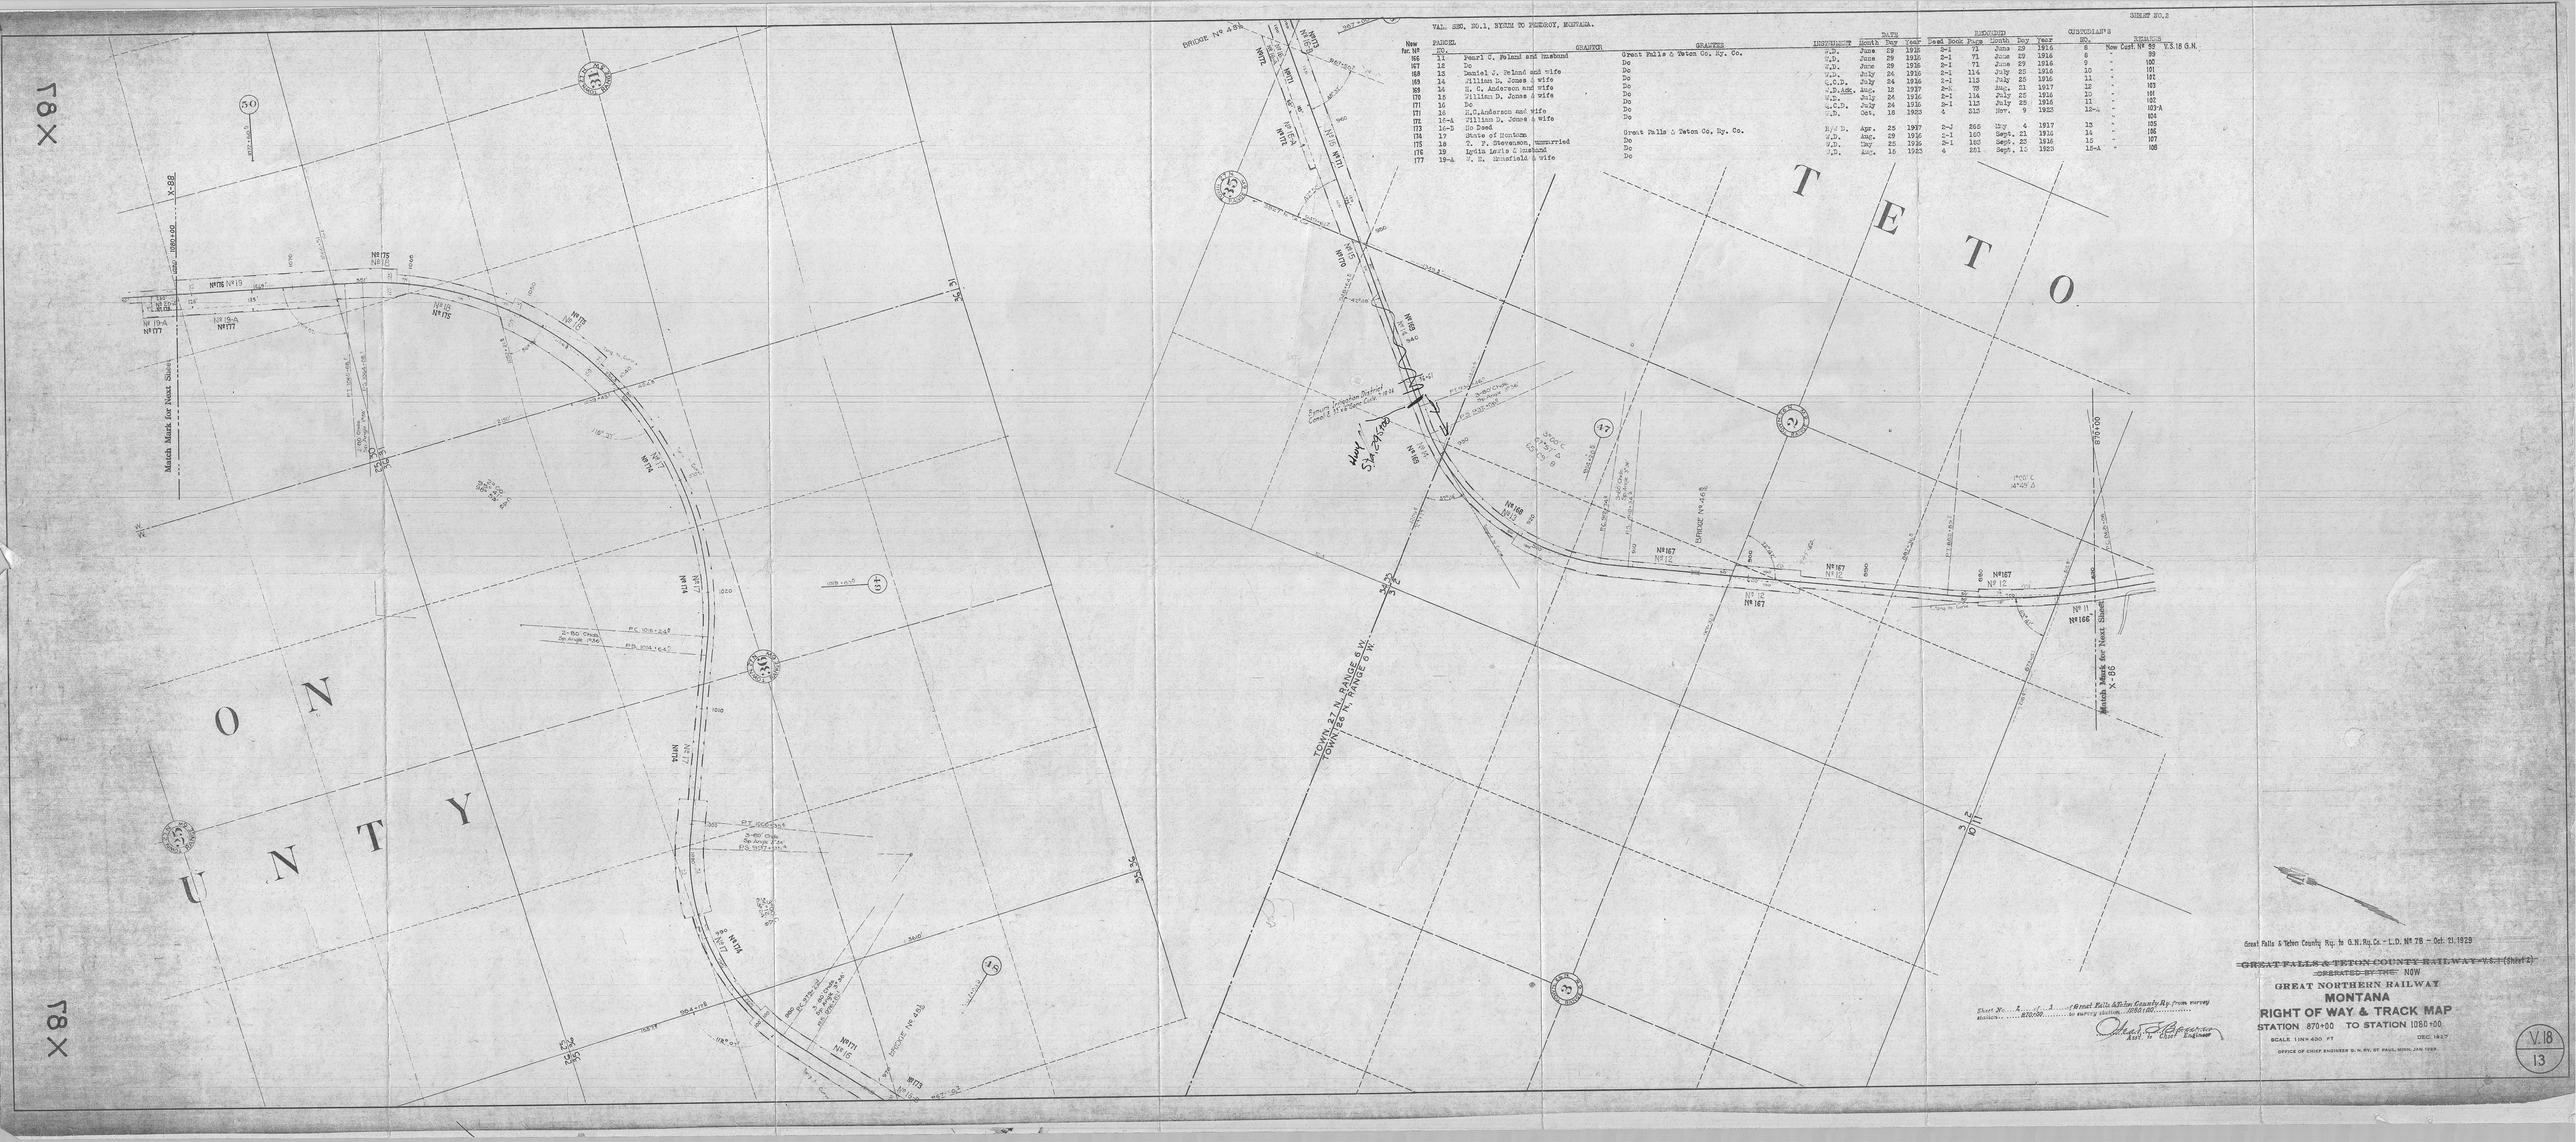
VAL. ENG. NO.1, BYRON TO PUCHOOT, MONTANA.
SHEET NO.2
New Rec.Nº
PARCEL
GRANTOR
GRANTEE
INSTRUMENT
DATE Month Day Year
RECORDED Book Page
CONSIDERATION
REMARKS
Nº 166 11 Pearl C. Pelland and husband Great Falls & Teton Co. Ry. Co. W.D. June 29 1916 2-1 71 June 29 1916 8 - 99
Nº 167 12 Do Do W.D. June 29 1916 2-1 71 June 29 1916 9 - 100
Nº 168 13 Daniel J. Pelland and wife Do W.D. July 24 1916 2-1 114 July 25 1916 10 - 101
Nº 169 14 William D. Jones & wife Do C.D.D. July 24 1916 2-1 115 July 25 1916 11 - 102
Nº 168 14 H. C. Anderson and wife Do W.D.&M. Aug. 12 1917 2-1 78 Aug. 21 1917 12 - 103
Nº 170 15 William D. Jones & wife Do W.D. July 24 1916 2-1 114 July 25 1916 10 - 101
Nº 171 16 Do Do C.D.D. July 24 1916 2-1 115 July 25 1916 11 - 102
Nº 171 16 H.C.Anderson and wife Do W.D. Oct. 18 1923 4 313 Nov. 9 1925 15-A - 102-A
Nº 172 16-A William D. Jones & wife Do 104
Nº 173 16-B No Deed 102
Nº 174 17 State of Montana Great Falls & Teton Co. Ry. Co. R/W D. Apr. 25 1917 2-J 268 May 4 1917 13 - 106
Nº 174 17 Do Do W.D. Aug. 29 1916 2-1 160 Sept. 21 1916 14 - 107
Nº 175 18 T. F. Stevenson, unmarried Do W.D. May 25 1916 2-1 163 Sept. 25 1916 15 - 108
Nº 176 19 Lydia Lewis & husband Do W.D. Aug. 15 1923 4 201 Sept. 12 1923 15-A -
Nº 177 19-A W. H. Rinsfield & wife Do
BRIDGE Nº 48A
BRIDGE Nº 46B
TETON
ON
UNTY
TOWN 27 N. RANGE 6 W.
TOWN 26 N. RANGE 6 W.
Match Mark for Next Sheet
Great Falls & Teton County Ry. to G.N.Ry.Co. - L.D. Nº 78 - Oct. 11.1929
~~GREAT FALLS & TETON COUNTY RAILWAY V.C. (Sheet 2)~~
~~OPERATED BY THE~~ NOW
GREAT NORTHERN RAILWAY
MONTANA
RIGHT OF WAY & TRACK MAP
STATION 870+00 TO STATION 1050+00.
SCALE 1 IN = 400 FT
DEC. 1927
OFFICE OF CHIEF ENGINEER G. N. RY. ST. PAUL, MINN. JAN. 1928.
V.18
13